


1 LOCATION OF WATER WELL: <b>Sedgwick</b>	FRACTION <b>NE 1/4 SE 1/4 NE 1/4</b>	Section Number <b>30</b>	Township Number <b>T 27 S</b>	Range Number <b>R 1E E/W</b>
--	---	-----------------------------	----------------------------------	---------------------------------

Distance and direction from nearest town or city street address of well if located within city?

**Seneca & Dayton Wichita, Kansas**

2 WATER WELL OWNER: <b>CITY OF WICHITA</b> RR#, ST. ADDRESS, BOX #: <b>P.O. Box 9163</b> CITY, STATE, ZIP CODE: <b>Wichita, Kansas 67277</b>	Board of Agriculture, Division of Water Resource Application Number: <b>950378</b>
---	---

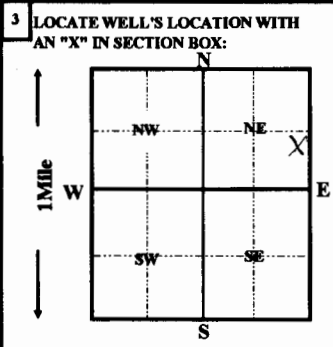

4 DEPTH OF COMPLETED WELL <b>40</b> ft.	ELEVATION:	
Depth(s) groundwater Encountered 1 ft.	2 ft.	3 ft.
WELL'S STATIC WATER LEVEL <b>15</b> FT. BELOW LAND SURFACE MEASURED ON <b>mo/day/yr</b> <b>12/12/1995</b>		
Pump test data: Well water was ft. after hours pumping gpm		
Est. Yield gpm:	Well water was ft. after hours pumping	gpm
Bore Hole Diameter <b>12</b> in. to <b>40</b> ft.	and in. to ft.	
WELL WATER TO BE USED AS:		
1 Domestic	3 Feedlot	6 Oil field water supply
2 Irrigation	4 Industrial	7 Lawn and garden only
		8 Air conditioning
		9 Dewatering
		10 Monitoring well
11 Injection well		
12 Other (Specify below)		
Was a chemical/bacteriological sample submitted to Department? Yes		No <b>X</b> ; If yes, mo/day/yr sample was submitted
Water Well Disinfected? Yes <b>X</b>		No

5 TYPE OF CASING USED:	5 Wrought iron	8 Concrete tile	CASING JOINTS:
1 Steel	3 RMP (SR)	6 Asbestos-Cement	Glued <b>X</b> Clamped
2 PVC	4 ABS	7 Fiberglass	Welded
		<b>SDR-26</b>	Threaded
Blank casing Diameter <b>8</b> in. to <b>20</b> ft., Dia	in. to ft.	ft., Dia	in. to ft.
Casing height above land surface <b>12</b> in.,	weight <b>2.35</b> lbs. / ft.	Wall thickness or gauge No. <b>.214</b>	
TYPE OF SCREEN OR PERFORATION MATERIAL:			
1 Steel	3 Stainless steel	5 Fiberglass	8 RMP (SR)
2 Brass	4 Galvanized steel	6 Concrete tile	9 ABS
SCREEN OR PERFORATION OPENING ARE:			10 Asbestos-cement
1 Continuous slot	3 Mill slot	5 Gauzed wrapped	8 Saw cut
2 Louvered shutter	4 Key punched	6 Wire wrapped	9 Drilled holes
		7 Torch cut	10 Other (specify)
SCREEN-PERFORATION INTERVALS:			11 None (open hole)
from <b>20</b> ft. to <b>40</b> ft., From	ft. to	ft., From	ft. to
GRAVEL PACK INTERVALS:	from <b>20</b> ft. to <b>40</b> ft., From	ft. to	ft. to
from	ft. to	ft., From	ft. to

6 GROUT MATERIAL:	1 Neat cement	2 Cement grout	3 Bentonite	4 Other <b>bentonite hole plug</b>
Grout Intervals: From <b>0</b> ft. to <b>20</b> ft. From	ft. From	ft. to	ft. From	ft. to
What is the nearest source of possible contamination:				
1 Septic tank	4 Lateral lines	7 Pit privy	10 Livestock pens	14 Abandon water well
2 Sewer lines	5 Cess pool	8 Sewage lagoon	11 Fuel storage	15 Oil well/Gas well
3 Watertight sewer lines	6 Seepage pit	9 Feedyard	12 Fertilizer storage	16 Other (specify below)
			13 Insecticide storage	<b>None Apparent</b>

Direction from well?		How many feet?			
FROM	TO	LITHOLOGIC LOG	FROM	TO	PLUGGING INTERVALS
<b>0</b>	<b>3</b>	<b>topsoil</b>			
<b>3</b>	<b>14</b>	<b>clay</b>			
<b>14</b>	<b>27</b>	<b>fine sand</b>			
<b>27</b>	<b>40</b>	<b>medium sand</b>			

7 CONTRACTOR'S OR LANDOWNER'S CERTIFICATION: This water well was (1) constructed, (2) reconstructed, or (3) plugged under my jurisdiction and was completed on (mo/day/year) <b>12/12/1995</b> and this record is true to the best of my knowledge and belief. Kansas Water Well Contractor's License No. <b>236</b> This Water Well Record was completed on (mo/day/yr) <b>12/31/95</b> Under the business name of <b>Harp Well &amp; Pump Service, Inc.</b> by (signature)	
--	--

*Jane Frederick*