


1 LOCATION OF WATER WELL: Sedgwick FRACTION NE 1/4 SE 1/4 NE 1/4 Section Number 30 Township Number T 27 S Range Number R 1E E/W

Distance and direction from nearest town or city street address of well if located within city? Seneca & Dayton Wichita, Kansas

2 WATER WELL OWNER: CITY OF WICHITA RR#, ST. ADDRESS, BOX #: P.O. Box 9163 CITY, STATE, ZIP CODE: Wichita, Kansas 67277 Board of Agriculture, Division of Water Resource Application Number: 950378

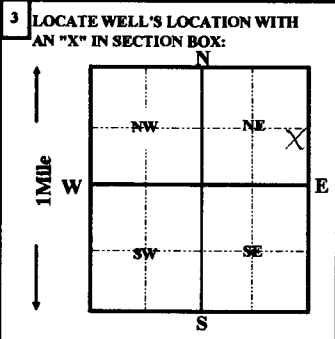

3 LOCATE WELL'S LOCATION WITH AN "X" IN SECTION BOX: 4 DEPTH OF COMPLETED WELL 40 ft. ELEVATION: 15 FT. BELOW LAND SURFACE MEASURED ON 12/12/1995. Includes pump test data, well water static level, and casing details.

5 TYPE OF CASING USED: 1 Steel, 2 PVC, 3 RMP (SR), 4 ABS, 5 Wrought iron, 6 Asbestos-Cement, 7 Fiberglass, 8 Concrete tile, 9 Other (Specify below), 10 Asbestos-cement, 11 Injection well, 12 Other (Specify below). Includes casing diameter (8 in), casing height (12 in), and screen/perforation details.

6 GROUT MATERIAL: 1 Neat cement, 2 Cement grout, 3 Bentonite, 4 Other bentonite hole plug. Includes grout intervals (0 to 20 ft) and contamination sources (septic tank, sewer lines, etc.).

Table with columns: FROM, TO, LITHOLOGIC LOG, FROM, TO, PLUGGING INTERVALS, How many feet? Lithologic log includes topsoil, clay, fine sand, and medium sand.

7 CONTRACTOR'S OR LANDOWNER'S CERTIFICATION: This water well was (1) constructed, (2) reconstructed, or (3) plugged under my jurisdiction and was completed on (mo/day/year) 12/12/1995 and this record is true to the best of my knowledge and belief. Kansas Water Well Contractor's License No. 236. This Water Well Record was completed on (mo/day/yr) 12/31/95. Under the business name of Harp Well & Pump Service, Inc. by (signature) Jane Frederick