


1 LOCATION OF WATER WELL: County: <u>Sedgwich</u>	Fraction <u>NW</u> $\frac{1}{4}$ <u>SE</u> $\frac{1}{4}$ <u>NW</u> $\frac{1}{4}$	Section Number <u>21</u>	Township Number <u>T 27</u> <u>S</u>	Range Number <u>R 1E</u> <u>XE</u>
--	---	-----------------------------	---	---------------------------------------

Distance and direction from nearest town or city street address of well if located within city?

235 North St. Francis St. Wichita, Kansas

2 WATER WELL OWNER: RR#, St. Address, Box # : City, State, ZIP Code	<u>Coleman Company</u> <u>235 North St. Francis St.</u> <u>Wichita, Kansas 67202</u>	Board of Agriculture, Division of Water Resources Application Number:
---	--	--

3 LOCATE WELL'S LOCATION WITH AN "X" IN SECTION BOX:	4 DEPTH OF COMPLETED WELL... <u>23.0</u> ft. ELEVATION: ... Depth(s) Groundwater Encountered 1. <u>17</u> ft. 2. ... ft. 3. ... ft.
--	--

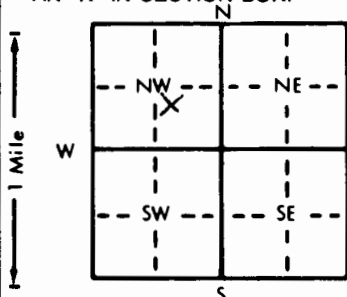

WELL'S STATIC WATER LEVEL ... ft. below land surface measured on mo/day/yr	
Pump test data: Well water was ... ft. after ... hours pumping ... gpm	Est. Yield ... gpm; Well water was ... ft. after ... hours pumping ... gpm
Bore Hole Diameter: <u>7 1/4</u> in. to <u>23</u> ft. and ... in. to ... ft.	
WELL WATER TO BE USED AS:	
1 Domestic	3 Feedlot
2 Irrigation	4 Industrial
5 Public water supply	6 Oil field water supply
7 Lawn and garden only	8 Air conditioning
9 Dewatering	10 Monitoring well
11 Injection well	12 Other (Specify below)
Was a chemical/bacteriological sample submitted to Department? Yes ... No ...; If yes, mo/day/yr sample was submitted	
Water Well Disinfected? Yes ... No ...	

5 TYPE OF BLANK CASING USED:	5 Wrought iron	8 Concrete tile	CASING JOINTS: Glued ... Clamped ...
1 Steel	3 RMP (SR)	6 Asbestos-Cement	9 Other (specify below)
2 PVC	4 ABS	7 Fiberglass	10 Asbestos-cement
Blank casing diameter ... in. to ... ft. Dia			11 Other (specify) ...
Casing height above land surface ... in., weight ... lbs./ft. Wall thickness or gauge No.			12 None used (open hole)

TYPE OF SCREEN OR PERFORATION MATERIAL:	
1 Steel	3 Stainless steel
2 Brass	4 Galvanized steel
5 Fiberglass	8 RMP (SR)
6 Concrete tile	9 ABS
10 Asbestos-cement	11 Other (specify) ...
12 None used (open hole)	

SCREEN OR PERFORATION OPENINGS ARE:	
1 Continuous slot	3 Mill slot <u>0.10</u>
2 Louvered shutter	4 Key punched
5 Gauzed wrapped	8 Saw cut
6 Wire wrapped	9 Drilled holes
7 Torch cut	10 Other (specify) ...
11 None (open hole)	

SCREEN-PERFORATED INTERVALS: From ... ft. to ... ft., From ... ft. to ... ft.	
GRAVEL PACK INTERVALS: From ... ft. to ... ft., From ... ft. to ... ft.	

6 GROUT MATERIAL:	1 Neat cement	2 Cement grout	3 Bentonite	4 Other
Grout Intervals: From ... ft. to ... ft., From ... ft. to ... ft.				

What is the nearest source of possible contamination:	
1 Septic tank	4 Lateral lines
2 Sewer lines	5 Cess pool
3 Watertight sewer lines	6 Seepage pit
7 Pit privy	8 Sewage lagoon
9 Feedyard	10 Livestock pens
11 Fuel storage	12 Fertilizer storage
13 Insecticide storage	14 Abandoned water well
15 Oil well/Gas well	16 Other (specify below)
Direction from well? <u>West</u>	
How many feet? <u>73'</u>	

FROM	TO	LITHOLOGIC LOG	FROM	TO	PLUGGING INTERVALS
0	8"	CONCRETE			
8"	3'	Topsoil & Fill			
		SOME COAL & COKE			
3'	5'	Silty tan clay			
5'	10'	Tan to Brn Silty clay			
10'	15'	FINE SAND			
15	23	MEDIUM TO COARSE SAND			
		Saturated at 16.5			

7 CONTRACTOR'S OR LANDOWNER'S CERTIFICATION: This water well was (1) constructed, (2) reconstructed, or (3) plugged under my jurisdiction and was completed on (mo/day/year) ... <u>1-25-96</u> ... and this record is true to the best of my knowledge and belief. Kansas Water Well Contractor's License No. <u>575</u> ... This Water Well Record was completed on (mo/day/yr) ... <u>2-5-96</u> ... under the business name of <u>Kurtz Environmental Service</u> by (signature) <u>[Signature]</u>
---