

1 LOCATION OF WATER WELL: County: <u>Sedgwick</u>	Fraction <u>SW</u> $\frac{1}{4}$ <u>SW</u> $\frac{1}{4}$ <u>SE</u> $\frac{1}{4}$	Section Number <u>5</u>	Township Number <u>T 27</u> <u>S</u>	Range Number <u>R 1</u> <u>EW</u>
--	---	----------------------------	---	--------------------------------------

Distance and direction from nearest town or city street address of well if located within city?


618 W. 21st; Wichita, KS

2 WATER WELL OWNER: RR#, St. Address, Box # : City, State, ZIP Code :	<u>Darryl Schaar / Universal Mtr. Fuel</u> <u>2824 N. Ohio</u> <u>Wichita, KS. 67219</u>
---	--

Board of Agriculture, Division of Water Resources

Application Number:

3 LOCATE WELL'S LOCATION WITH AN "X" IN SECTION BOX:	4 DEPTH OF COMPLETED WELL: <u>20'6"</u> ft. ELEVATION:
--	--

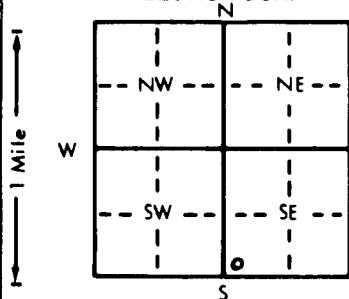

Depth(s) Groundwater Encountered 1.13' ft. 2. ft. 3. ft.

WELL'S STATIC WATER LEVEL 12.38 ft. below land surface measured on mo/day/yr 4-18-96

Pump test data: Well water was ft. after hours pumping gpm

Est. Yield gpm: Well water was ft. after hours pumping gpm

Bore Hole Diameter 8 1/2" in. to 20'6" ft., and in. to ft.

WELL WATER TO BE USED AS: 5 Public water supply 8 Air conditioning 11 Injection well

1 Domestic 3 Feedlot 6 Oil field water supply 9 Dewatering 12 Other (Specify below)

2 Irrigation 4 Industrial 7 Lawn and garden only 10 Monitoring well

Was a chemical/bacteriological sample submitted to Department? Yes No X; If yes, mo/day/yr sample was submitted Water Well Disinfected? Yes No

5 TYPE OF BLANK CASING USED:	5 Wrought iron	8 Concrete tile	CASING JOINTS: Glued Clamped
------------------------------	----------------	-----------------	------------------------------

1 Steel 3 RMP (SR)

2 PVC 4 ABS

Blank casing diameter 2.375 in. to 10' ft., Dia

Casing height above land surface Flush Mt in., weight

TYPE OF SCREEN OR PERFORATION MATERIAL:

1 Steel 3 Stainless steel

2 Brass 4 Galvanized steel

SCREEN OR PERFORATION OPENINGS ARE:

1 Continuous slot 3 Mill slot

2 Louvered shutter 4 Key punched

SCREEN-PERFORATED INTERVALS:

From 20' ft. to 10' ft.

GRAVEL PACK INTERVALS:

From 20'6" ft. to 8' ft.

From ft. to ft.

From ft. to ft.

6 GROUT MATERIAL:	1 Neat cement	<u>2</u> Cement grout	<u>3</u> Bentonite	4 Other
-------------------	---------------	-----------------------	--------------------	---------

Grout intervals: From 8' ft. to 4' ft., From 4' ft. to 0' ft., From ft. to ft.

What is the nearest source of possible contamination:

1 Septic tank 4 Lateral lines

2 Sewer lines 5 Cess pool

3 Watertight sewer lines 6 Seepage pit

7 Pit privy

8 Sewage lagoon

9 Feedyard

10 Livestock pens

11 Fuel storage Fayer

12 Fertilizer storage

13 Insecticide storage

14 Abandoned water well

15 Oil well/Gas well

16 Other (specify below)

Direction from well? Intank Pit

How many feet? 0'

FROM TO LITHOLOGIC LOG FROM TO PLUGGING INTERVALS

0 3.25 Glass-Black-Dk Brn sandy clayey

silt to sandy silty clay, moist, no odor

3.25 6.0 Fine grained, sandy silt to silty sand

oxides, moist today, no odor

6.0 11.25 Fine grained sand, dry, no odor

oxide stains, well rounded & sorted

11.25 20'6" Fine-grained, silty clay to black

sand, wet at 13-13 1/2', strong odor

poorly sorted - sub rounded grains

7 CONTRACTOR'S OR LANDOWNER'S CERTIFICATION: This water well was (1) constructed (2) reconstructed, or (3) plugged under my jurisdiction and was completed on (mo/day/year) 4-17-96 and this record is true to the best of my knowledge and belief. Kansas

Water Well Contractor's License No. 539 This Water Well Record was completed on (mo/day/yr) 5-4-96

under the business name of QB Environmental Drilling by (signature) James Becker