


1 LOCATION OF WATER WELL: Fraction SE 1/4 NE 1/4 NE 1/4 Section Number 21 Township Number T 27 S Range Number R 1 EW  
 County: Sedgwick

Distance and direction from nearest town or city street address of well if located within city?  
1630 East 2nd., Wichita, Ks. 67214

2 WATER WELL OWNER: Alice Schwartz/Car Care  
 RR#, St. Address, Box # : 1630 E. 2nd Board of Agriculture, Division of Water Resources  
 City, State, ZIP Code : Wichita, Ks. 67214 Application Number:

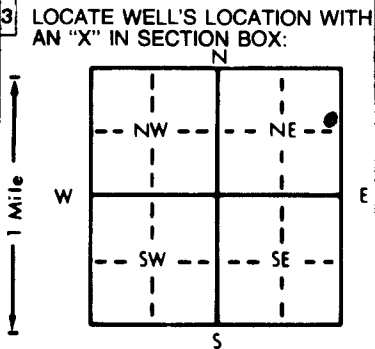

4 DEPTH OF COMPLETED WELL 22 1/2' ft. ELEVATION: .....  
 Depth(s) Groundwater Encountered 1. 15' ft. 2. .... ft. 3. .... ft.  
 WELL'S STATIC WATER LEVEL 14.25 ft. below land surface measured on mo/day/yr 5-14-96  
 Pump test data: Well water was ..... ft. after ..... hours pumping ..... gpm  
 Est. Yield ..... gpm; Well water was ..... ft. after ..... hours pumping ..... gpm  
 Bore Hole Diameter: 8 1/2" in. to 22 1/2" in. to ..... in. to ..... in.  
 WELL WATER TO BE USED AS: 5 Public water supply 8 Air conditioning 11 Injection well  
 1 Domestic 3 Feedlot 6 Oil field water supply 9 Dewatering 12 Other (Specify below)  
 2 Irrigation 4 Industrial 7 Lawn and garden only 10 Monitoring well  
 Was a chemical/bacteriological sample submitted to Department? Yes.....No. X.....; If yes, mo/day/yr sample was submitted  
 Water Well Disinfected? Yes No

5 TYPE OF BLANK CASING USED: 1 Steel 3 RMP (SR) 5 Wrought iron 8 Concrete tile CASING JOINTS: Glued ..... Clamped .....  
2 PVC 4 ABS 7 Fiberglass 9 Other (specify below) Welded .....  
 Blank casing diameter 2 3/8 in. to 12' ft., Dia ..... in. to SDR 13 ft.  
 Casing height above land surface Flush Mt. in., weight ..... lbs./ft. Wall thickness or gauge No. SCH 40  
 TYPE OF SCREEN OR PERFORATION MATERIAL: 7 PVC 10 Asbestos-cement  
 1 Steel 3 Stainless steel 5 Fiberglass 8 RMP (SR) 11 Other (specify) .....  
 2 Brass 4 Galvanized steel 6 Concrete tile 9 ABS 12 None used (open hole)  
 SCREEN OR PERFORATION OPENINGS ARE: 5 Gauzed wrapped 8 Saw cut 11 None (open hole)  
 1 Continuous slot 3 Mill slot 6 Wire wrapped 9 Drilled holes  
 2 Louvered shutter 4 Key punched 7 Torch cut, 10 Other (specify) .....  
 SCREEN-PERFORATED INTERVALS: From 22' ft. to 12' ft., From ..... ft. to ..... ft.  
 From ..... ft. to ..... ft., From ..... ft. to ..... ft.  
 GRAVEL PACK INTERVALS: From 22' 6" ft. to 10 1/2' ft., From ..... ft. to ..... ft.  
 From ..... ft. to ..... ft., From ..... ft. to ..... ft.

6 GROUT MATERIAL: 1 Neat cement 2 Cement grout 3 Bentonite 4 Other  
 Grout Intervals: From 10 1/2' ft. to 4' ft., From 4' ft. to 0' ft., From ..... ft. to ..... ft.  
 What is the nearest source of possible contamination: 1 Septic tank 4 Lateral lines 7 Pit privy 10 Livestock pens 14 Abandoned water well  
 2 Sewer lines 5 Cess pool 8 Sewage lagoon 11 Fuel storage FULL 15 Oil well/Gas well  
 3 Watertight sewer lines 6 Seepage pit 9 Feedyard 12 Fertilizer storage 16 Other (specify below)  
 13 Insecticide storage  
 Direction from well? Northwest How many feet? 175'

FROM	TO	LITHOLOGIC LOG	FROM	TO	PLUGGING INTERVALS
0	3.50	Grass-Dk brn silty clay, mottled, earthy odor, moist, root frag.			
7.50	15	Fine grained sand, well rounded, & sorted, dry no odor.	3.50	1.50	1/2 Bin pit, clay to clayey silt, holes today, no odor, low plasticity
15	22.50	Fine-coarse grained sand & gravel, wet, rounded, poorly sorted grains.			

FIN. OK'd by Don Taylor

7 CONTRACTOR'S OR LANDOWNER'S CERTIFICATION: This water well was (1) constructed (2) reconstructed, or (3) plugged under my jurisdiction and was completed on (mo/day/year) 5-14-96 and this record is true to the best of my knowledge and belief. Kansas Water Well Contractor's License No. 539. This Water Well Record was completed on (mo/day/yr) 5-18-96 under the business name of JB Environmental Drilling by (signature) James Baker

INSTRUCTIONS: Use typewriter or ball point pen. PLEASE PRESS FIRMLY and PRINT clearly. Please fill in blanks, underline or circle the correct answers. Send top three copies to Kansas Department of Health and Environment, Bureau of Water, Topeka, Kansas 66620-0001. Telephone: 913-296-5545. Send one to WATER WELL OWNER and retain one for your records.

OFFICE USE ONLY  
T  
R  
EW  
SEC.  
1/4  
1/4  
1/4