

NW-5 #2411025

WATER WELL RECORD Form WWC-5 KSA 82a-1212


1 LOCATION OF WATER WELL:	Fraction	Section Number	Township Number	Range Number
County: Sedgwick	NW 1/4 NW 1/4 SE 1/4	28	T 27 S	R 1 E/W

Distance and direction from nearest town or city street address of well if located within city?

1023 E. Lincoln

2 WATER WELL OWNER: Total Petroleum	Board of Agriculture, Division of Water Resources
RR#, St. Address, Box #: 999 18th St. P.O. Box 500	Application Number:
City, State, ZIP Code: Denver, CO 80201	

3 LOCATE WELL'S LOCATION WITH AN "X" IN SECTION BOX:	4 DEPTH OF COMPLETED WELL: 21 ft. ELEVATION:
--	--

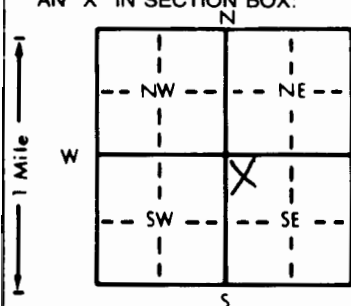

Depth(s) Groundwater Encountered 16.18 ft. 2. ft. 3. ft.

WELL'S STATIC WATER LEVEL 16.18 ft. below land surface measured on mo/day/yr 10-11-96

Pump test data: Well water was ft. after hours pumping gpm

Est. Yield gpm: Well water was ft. after hours pumping gpm

Bore Hole Diameter 8 in. to ft. and in. to ft.

WELL WATER TO BE USED AS: 5 Public water supply 8 Air conditioning 11 Injection well

1 Domestic 3 Feedlot 6 Oil field water supply 9 Dewatering 12 Other (Specify below)

2 Irrigation 4 Industrial 7 Lawn and garden only 10 Monitoring well

Was a chemical/bacteriological sample submitted to Department? Yes No X If yes, mo/day/yr sample was submitted

Water Well Disinfected? Yes No X

5 TYPE OF BLANK CASING USED:	5 Wrought iron	8 Concrete tile	CASING JOINTS: Glued Clamped
------------------------------	----------------	-----------------	------------------------------

1 Steel 3 RMP (SR)

2 PVC 4 ABS

6 Asbestos-Cement 9 Other (specify below)

7 Fiberglass

Welded Threaded Flush

Blank casing diameter 2 in. to ft. Dia in. to ft. Dia in. to ft.

Casing height above land surface flush in. weight 0.703 lbs./ft. Wall thickness or gauge No. 40

TYPE OF SCREEN OR PERFORATION MATERIAL: PVC 10 Asbestos-cement

1 Steel 3 Stainless steel

5 Fiberglass 8 RMP (SR)

11 Other (specify)

2 Brass 4 Galvanized steel

6 Concrete tile

9 ABS

12 None used (open hole)

SCREEN OR PERFORATION OPENINGS ARE: 5 Gauzed wrapped 8 Saw cut 11 None (open hole)

1 Continuous slot 3 Mill slot

6 Wire wrapped

9 Drilled holes

2 Louvered shutter 4 Key punched

7 Torch cut

10 Other (specify)

SCREEN-PERFORATED INTERVALS: From 11 ft. to 21 ft. From ft. to ft.

From ft. to ft. From ft. to ft.

GRAVEL PACK INTERVALS: From 9 ft. to 21 ft. From ft. to ft.

From ft. to ft. From ft. to ft.

6 GROUT MATERIAL:	1 Neat cement	2 Cement grout	3 Bentonite	4 Other
-------------------	---------------	----------------	-------------	---------

Grout Intervals: From 1 ft. to 9 ft. From ft. to ft. From ft. to ft.

What is the nearest source of possible contamination: 10 Livestock pens 14 Abandoned water well

1 Septic tank 4 Lateral lines

7 Pit privy

11 Fuel storage

15 Oil well/Gas well

2 Sewer lines 5 Cess pool

8 Sewage lagoon

12 Fertilizer storage

16 Other (specify below)

3 Watertight sewer lines 6 Seepage pit

9 Feedyard

13 Insecticide storage

Direction from well? N How many feet? 350

FROM TO LITHOLOGIC LOG FROM TO PLUGGING INTERVALS

0 1 Topsoil

1 3.5 Clay

3.5 8 Sand, fine grained

8 15 Sand, medium grained

15 21 Sand, coarse to medium grained

7 CONTRACTOR'S OR LANDOWNER'S CERTIFICATION: This water well was (1) constructed, (2) reconstructed, or (3) plugged under my jurisdiction and was completed on (mo/day/year) 10-11-96 and this record is true to the best of my knowledge and belief. Kansas Water Well Contractor's License No. 531 This Water Well Record was completed on (mo/day/yr) 10-17-96 under the business name of GSI by (signature) Candace Watson
--

INSTRUCTIONS: Use typewriter or ball point pen. PLEASE PRESS FIRMLY and PRINT clearly. Please fill in blanks, underline or circle the correct answers. Send top three copies to Kansas Department of Health and Environment, Bureau of Water, Topeka, Kansas 66620-0001. Telephone: 913-296-5545. Send one to WATER WELL OWNER and retain one for your records.