
	WATI	ER WELL RECORD F	orm WWC-5	KSA 82	a-1212	PLUGGING REPORT	
LOCATION OF WATER WEL	L: Fraction			ion Number	0.7	1	
County: Sedgwick	NE 1/			18	т 27	s R 1	E/ <b>W</b>
Distance and direction from nea			within city?				
In Sims Memorial P							
WATER WELL OWNER:	City of W						
RR#, St. Address, Box # :	455 N. Ma				•	riculture, Division of Water F	Resource
City, State, ZIP Code	12.2					Number: NA	
LOCATE WELL'S LOCATION AN "X" IN SECTION BOX:	Depth(s) Ground	COMPLETED WELL	4.7	. ft. ELEV	ATION:	ft. 3	
NW NE	Est. Yield Bore Hole Diam	np test data: Well water gpm: Well water neter in. to . 秋夕香隆 USED AS: 5 c 3 Feedlot 6	was	ft. ft. ft. ft. ft., supply er supply	after	hours pumping	gpmft.
	Was a chemical	l/bacteriological sample su	ubmitted to De	partment?	/esNo	; If yes, mo/day/yr sample	was sub
. s	mitted			W	ater Well Disinfected	? Yes No	
TYPE OF BLANK CASING L	JSED:	5 Wrought iron	8 Concre	te tile	CASING JOIN	ITS: Glued Clamped	1 <i>.</i> .
<b>→</b>	RMP (SR)	6 Asbestos-Cement		specify belo	ow)	Welded	<i>.</i>
<del></del>	ABS	7 Fiberglass		·		Threaded	
Blank casing diameter			in. to		ft., Dia	in. to	ft.
Casing height above land surface	ce 8.3' below*	in weight		lbs	/ft. Wall thickness or	gauge No	
TYPE OF SCREEN OR PERFO			7 PVC			stos-cement	
	Stainless steel	5 Fiberglass		P (SR)		r (specify)	
		•	9 ABS	` '			
	Galvanized steel	6 Concrete tile		•		used (open hole)	\
SCREEN OR PERFORATION (			d wrapped		8 Saw cut	11 None (open l	noie)
1 Continuous slot	3 Mill slot		rapped		9 Drilled holes	1/4	
2 Louvered shutter	4 Key punched	ン() 7 Torch (	cut (2(2()		10 Other (specify)	ft. to	· · · · · · ·
SCREEN-PERFORATED INTER							
						ft. to	
GRAVEL PACK INTE	RVALS: From	ft. to		ft., Fro	om	ft. to	ft.
	From	ft. to		ft., Fro	om	ft. to	ft.
	1 Neat cement		3 Bentor				
Grout Intervals: From $\dots \mathcal{Z}$	•	<i>5</i> ft., From	ft. t			ft. to	
What is the nearest source of n				10 LIVE			veli
		7 Pit privy			storage	15 Oil well/Gas well	ven
1 Septic tank	4 Lateral lines	7 Pit privy	on	11 Fuel	storage	15 Oil well/Gas well	
<ol> <li>Septic tank</li> <li>Sewer lines</li> </ol>	4 Lateral lines 5 Cess pool	8 Sewage lagor	on	11 Fuel 12 Fert	ilizer storage	15 Oil well/Gas well 16 Other (specify belov River	
<ol> <li>Septic tank</li> <li>Sewer lines</li> <li>Watertight sewer lines</li> </ol>	<ul><li>4 Lateral lines</li><li>5 Cess pool</li><li>6 Seepage pit</li></ul>	• •	on	11 Fuel 12 Fert 13 Inse	ilizer storage	16 Other (specify below	
Sewer lines     Watertight sewer lines     Direction from well? West	4 Lateral lines 5 Cess pool 6 Seepage pit t	8 Sewage lagoo 9 Feedyard		11 Fuel 12 Fert 13 Inse	ilizer storage cticide storage any feet? 200	16 Other (specify below River	
<ol> <li>Septic tank</li> <li>Sewer lines</li> <li>Watertight sewer lines</li> </ol>	<ul><li>4 Lateral lines</li><li>5 Cess pool</li><li>6 Seepage pit</li></ul>	8 Sewage lagoo 9 Feedyard	FROM	11 Fue 12 Fert 13 Inse How m	ilizer storage cticide storage any feet? 200 *	16 Other (specify below River	
Septic tank     Sewer lines     Watertight sewer lines Direction from well?  West	4 Lateral lines 5 Cess pool 6 Seepage pit t	8 Sewage lagoo 9 Feedyard	FROM 47.0	11 Fue 12 Fert 13 Inse How m TO 19.6	ilizer storage cticide storage any feet? 200' PLU Chlorinated	16 Other (specify below River JGGING INTERVALS grave1	
Septic tank     Sewer lines     Watertight sewer lines     West FROM TO	4 Lateral lines 5 Cess pool 6 Seepage pit t LITHOLOGIC	8 Sewage lagor 9 Feedyard C LOG	FROM 47.0 19.6	11 Fuel 12 Fert 13 Inse How m TO 19.6 8.3	ilizer storage cticide storage any feet? 200' Chlorinated Concrete gr	16 Other (specify below River JGGING INTERVALS grave1	
1 Septic tank 2 Sewer lines 3 Watertight sewer lines Direction from well? West FROM TO *The	4 Lateral lines 5 Cess pool 6 Seepage pit t LITHOLOGIC abandoned we11	8 Sewage lagor 9 Feedyard C LOG	FROM 47.0	11 Fue 12 Fert 13 Inse How m TO 19.6	ilizer storage cticide storage any feet? 200' PLU Chlorinated	16 Other (specify below River JGGING INTERVALS grave1	
1 Septic tank 2 Sewer lines 3 Watertight sewer lines Direction from well? West FROM TO *The	4 Lateral lines 5 Cess pool 6 Seepage pit t LITHOLOGIC abandoned well lished by other	8 Sewage lagor 9 Feedyard CLOG l vault was rs. 










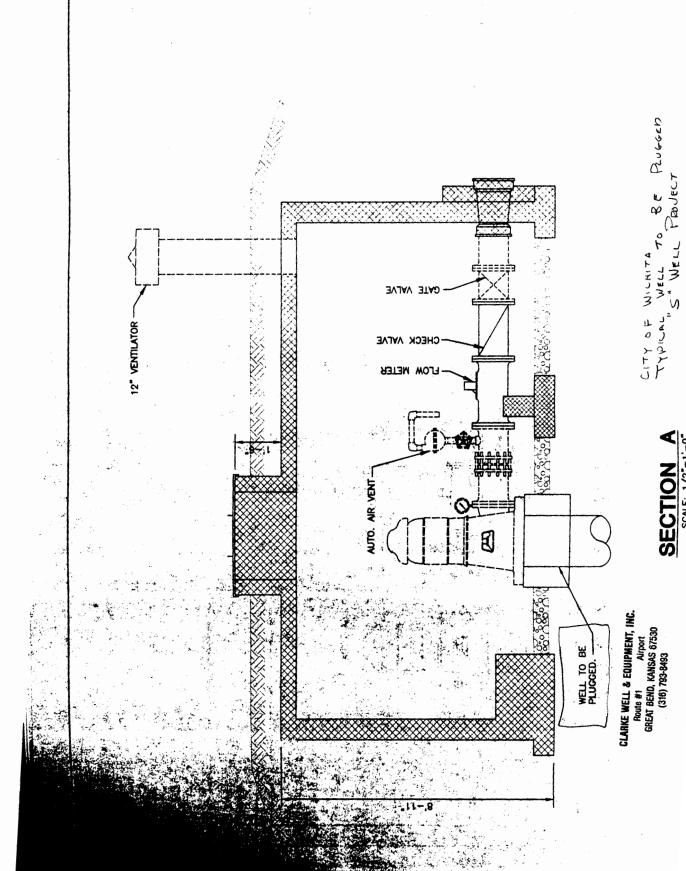

SCALE: 1/2"=1'-0"