

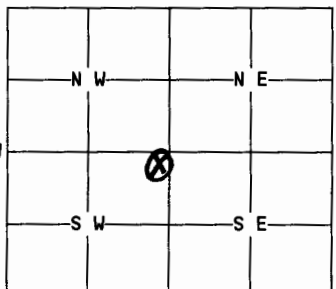
NE NW SW SE

1 LOCATION OF WATER WELL: County: Sedgwick	Fraction N 1/4 S 1/4 E 1/4	Section Number 122 124 32 126 128	Township, Number English 9th addition 27	Range Number 1E
--	--------------------------------------	---	--	---------------------------

Distance and direction from nearest town or city street address of well, if located within city?

2141 So. Waco**Wichita KS.**

2 WATER WELL OWNER: RR#, St. Address, Box #: City, State, ZIP Code :	Steve Stigall 2141 So Waco Wichita KS 67213	Board of Agriculture, Division of Water Resources Application Number:
--	--	--

3 MARK WELL'S LOCATION WITH AN "X" IN SECTION BOX: N  S	4 DEPTH OF WELL..... 21ft. WELL'S STATIC WATER LEVEL..... 15ft. WELL WAS USED AS: <input checked="" type="checkbox"/> 1 Domestic <input checked="" type="checkbox"/> 2 Irrigation <input type="checkbox"/> 3 Feedlot <input type="checkbox"/> 4 Industrial <input type="checkbox"/> 5 Public Water Supply <input type="checkbox"/> 6 Oil Field Water Supply <input checked="" type="checkbox"/> 7 Lawn and Garden Only <input type="checkbox"/> 8 Air Conditioning <input type="checkbox"/> 9 Dewatering <input type="checkbox"/> 10 Monitoring Well <input type="checkbox"/> 11 Injection Well <input type="checkbox"/> 12 Other..... Was a chemical/bacteriological sample submitted to Department? Yes.....No X .. If yes, mo/day/yr sample was submitted..... Water Well Disinfected: Yes..... No X
--	---

5 TYPE OF BLANK CASING USED: <input checked="" type="radio"/> 1 Steel <input type="radio"/> 2 PVC <input type="radio"/> 3 RMP (SR) <input type="radio"/> 4 ABS <input type="radio"/> 5 Wrought <input type="radio"/> 6 Asbestos-Cement <input type="radio"/> 7 Fiberglass <input type="radio"/> 8 Concrete Tile <input type="radio"/> 9 Other (specify below).....	Blank casing diameter..... 1 1/4 in. Was casing pulled? Yes..... No X ... If yes, how much..... Casing height above or below land surface..... 3 ft. Below in.
---	--

6 GROUT PLUG MATERIAL: <input type="radio"/> 1 Neat cement <input type="radio"/> 2 Cement grout <input type="radio"/> 3 Bentonite <input type="radio"/> 4 Other.. Portland Cement	Grout Plug Intervals: From.....ft. to.....ft., From.....ft. to.....ft., From..... to.....ft.
What is the nearest source of possible contamination: <input type="radio"/> 1 Septic tank <input type="radio"/> 6 Seepage pit <input type="radio"/> 11 Fuel storage <input type="radio"/> 16 Other (specify below)..... <input type="radio"/> 2 Sewer lines <input type="radio"/> 7 Pit privy <input type="radio"/> 12 Fertilizer storage <input checked="" type="radio"/> 3 Watertight sewer lines <input type="radio"/> 8 Sewage lagoon <input type="radio"/> 13 Insecticide storage <input type="radio"/> 4 Lateral lines <input type="radio"/> 9 Feedyard <input type="radio"/> 14 Abandoned water well <input type="radio"/> 5 Cess Pool <input type="radio"/> 10 Livestock pens <input type="radio"/> 15 Oil well/Gas well	
Direction from well? North How many feet? 3 FT	

FROM	TO	PLUGGING MATERIALS

7 CONTRACTOR'S OR LANDOWNER'S CERTIFICATION: This water well was plugged under my jurisdiction and was completed on (mo/day/year)..... 5/12/97 and this record is true to the best of my knowledge and belief. Kansas Water Well Contractor's License No. This Water Well Record was completed on (mo/day/year)..... 5/12/97 under the business name of owner
by (signature) Steve C Stigall

INSTRUCTIONS: Use typewriter or ball point pen. Please press firmly and print clearly. Please fill in blanks, underline or circle the correct answers. Send top three copies to Kansas Department of Health and Environment, Bureau of Water, Topeka, Kansas 66620-0001. Telephone: 913/296-3565. Send one to Water Well Owner and retain one for your records.