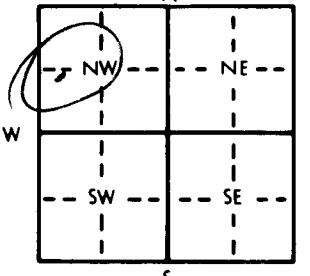


1 LOCATION OF WATER WELL: County: <u>Sedgwick</u> Fraction <u>NW 1/4 SW 1/4 NW 1/4</u> Section Number <u>5</u> Township Number <u>T 27 S</u> Range Number <u>R 1 E</u>	
Distance and direction from nearest town or city street address of well if located within city? <u>1219 W. 27th No.</u>	
2 WATER WELL OWNER: <u>Cathy Davis</u> RR#, St. Address, Box # : <u>1219 W. 27th No.</u> Board of Agriculture, Division of Water Resources City, State, ZIP Code : <u>WICHITA, KS 67204</u> Application Number:	
3 LOCATE WELL'S LOCATION WITH AN "X" IN SECTION BOX: 	4 DEPTH OF COMPLETED WELL: <u>25</u> ft. ELEVATION: Depth(s) Groundwater Encountered 1. <u>14 N/A</u> ft. 2. ft. 3. ft. WELL'S STATIC WATER LEVEL <u>14 N/A</u> ft. below land surface measured on mo/day/yr <u>10-3-96</u> Pump test data: Well water was ft. after hours pumping gpm Est. Yield gpm: Well water was ft. after hours pumping gpm Bore Hole Diameter in. to ft., and in. to ft. WELL WATER TO BE USED AS: 1 Domestic 3 Feedlot 5 Public water supply 8 Air conditioning 11 Injection well 2 Irrigation 4 Industrial 6 Oil field water supply 9 Dewatering 12 Other (Specify below) 7 Lawn and garden only 10 Monitoring well Was a chemical/bacteriological sample submitted to Department? Yes No <u>X</u> ; If yes, mo/day/yr sample was submitted Water Well Disinfected? Yes <u>X</u> No
5 TYPE OF BLANK CASING USED: 1 Steel 3 RMP (SR) 5 Wrought iron 8 Concrete tile CASING JOINTS: Glued Clamped 2 PVC 4 ABS 6 Asbestos-Cement 9 Other (specify below) Welded 7 Fiberglass <u>STYRENE</u> Threaded Blank casing diameter <u>5</u> in. to ft., Dia. in. to ft., Dia. in. to ft. Casing height above land surface <u>0</u> in., weight lbs./ft. Wall thickness or gauge No. TYPE OF SCREEN OR PERFORATION MATERIAL: 1 Steel 3 Stainless steel 5 Fiberglass 8 RMP (SR) 10 Asbestos-cement 2 Brass 4 Galvanized steel 6 Concrete tile 9 ABS 11 Other (specify) <u>N/A</u> 12 None used (open hole) SCREEN OR PERFORATION OPENINGS ARE: 1 Continuous slot 3 Mill slot 5 Gauzed wrapped 8 Saw cut 11 None (open hole) 2 Louvered shutter 4 Key punched 6 Wire wrapped 9 Drilled holes <u>N/A</u> 10 Other (specify) <u>N/A</u> SCREEN-PERFORATED INTERVALS: From <u>N/A</u> ft. to <u>N/A</u> ft., From ft. to ft. GRAVEL PACK INTERVALS: From <u>N/A</u> ft. to <u>N/A</u> ft., From ft. to ft.	
6 GROUT MATERIAL: 1 Neat cement 2 Cement grout 3 Bentonite 4 Other Grout Intervals: From <u>0</u> ft. to <u>10</u> ft., From ft. to ft., From ft. to ft. What is the nearest source of possible contamination: 1 Septic tank 4 Lateral lines 7 Pit privy 10 Livestock pens 14 Abandoned water well 2 Sewer lines 5 Cess pool 8 Sewage lagoon 11 Fuel storage 15 Oil well/Gas well 3 Watertight sewer lines 6 Seepage pit 9 Feedyard 12 Fertilizer storage 16 Other (specify below) 13 Insecticide storage Direction from well? <u>South</u> How many feet? <u>20</u>	
FROM TO LITHOLOGIC LOG	FROM TO PLUGGING INTERVALS
	<u>0 10 NEAT CEMENT</u> <u>10 25 CHLORINATED Sand &amp; Gravel</u>
	<u>Well was cemented in slab</u>
7 CONTRACTOR'S OR LANDOWNER'S CERTIFICATION: This water well was (1) constructed, (2) reconstructed, or (3) plugged under my jurisdiction and was completed on (mo/day/year) <u>10-3-96</u> and this record is true to the best of my knowledge and belief. Kansas Water Well Contractor's License No. <u>313</u> This Water Well Record was completed on (mo/day/yr) <u>10-3-96</u> under the business name of <u>JET DRILLING</u> by (signature) <u>[Signature]</u>	