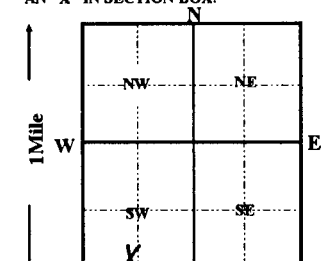


1 LOCATION OF WATER WELL: <b>Sedgwick</b>		FRACTION <b>NW SE 1/4 SW 1/4 SW 1/4</b>		Section Number <b>7</b>		Township Number <b>T 27 S</b>		Range Number <b>R 1E E/W</b>	
Distance and direction from nearest town or city street address of well if located within city? <b>1440 N. St. Clair Wichita, Kansas</b>									
WATER WELL OWNER: <b>DORR, Glen</b>		Board of Agriculture, Division of Water Resource							
RR#, ST. ADDRESS, BOX #: <b>1440 N. St. Clair</b>		Application Number:							
CITY, STATE, ZIP CODE: <b>Wichita, Kansas</b>									
LOCATE WELL'S LOCATION WITH AN "X" IN SECTION BOX: 		4 DEPTH OF WELL: <b>24</b> ft. ELEVATION: <b>basement floor</b> Depth(s) groundwater Encountered <b>1</b> ft. <b>2</b> ft. <b>3</b> ft. <b>ft.</b> WELL'S STATIC WATER LEVEL <b>12</b> FT. BELOW LAND SURFACE MEASURED ON <b>08/30/1999</b> Pump test data: Well water was <b>ft.</b> after <b>hours</b> pumping <b>gpm</b> Est. Yield <b>gpm</b> : Well water was <b>ft.</b> after <b>hours</b> pumping <b>gpm</b> Bore Hole Diameter <b>in.</b> to <b>ft.</b> and <b>in.</b> to <b>ft.</b> WELL WATER TO BE USED AS: <b>5</b> Public water supply <b>8</b> Air conditioning <b>11</b> Injection well <b>1</b> Domestic <b>3</b> Feedlot <b>6</b> Oil field water supply <b>9</b> Dewatering <b>12</b> Other (Specify below) <b>2</b> Irrigation <b>4</b> Industrial <b>7</b> Lawn and garden only <b>10</b> Monitoring well Was a chemical/bacteriological sample submitted to Department? Yes <b>No</b> ; If yes, mo/day/yr sample was submitted Water Well Disinfected? Yes <b>X</b> No							
5 TYPE OF CASING USED: 1 Steel 3 RMP (SR) 5 Wrought iron 8 Concrete tile CASING JOINTS: Glued Clamped 2 PVC 4 ABS 6 Asbestos-Cement 9 Other (Specify below) Welded 7 Fiberglass Threaded Blank casing Diameter <b>6</b> in. to <b>ft.</b> , Dia <b>in.</b> to <b>ft.</b> , Dia <b>in.</b> to <b>ft.</b> Casing height above land surface <b>24</b> in., weight <b>lbs. / ft.</b> Wall thickness or gauge No. TYPE OF SCREEN OR PERFORATION MATERIAL: 7 PVC 10 Asbestos-cement 1 Steel 3 Stainless Steel 5 Fiberglass 8 RMP (SR) 11 other (specify) <b>N/A</b> 2 Brass 4 Galvanized steel 6 Concrete tile 9 ABS 12 None used (open hole) SCREEN OR PERFORATION OPENING ARE: 5 Gauzed wrapped 8 Saw cut 11 None (open hole) 1 Continuous slot 3 Mill slot 6 Wire wrapped 9 Drilled holes 2 Louvered shutter 4 Key punched 7 Torch cut 10 Other (specify) <b>N/A</b> SCREEN-PERFORATION INTERVALS: from <b>ft. to</b> <b>ft., From</b> <b>ft. to</b> <b>ft.</b> GRAVEL PACK INTERVALS: from <b>ft. to</b> <b>ft., From</b> <b>ft. to</b> <b>ft.</b>									
6 GROUT MATERIAL: 1 Neat cement 2 Cement grout 3 Bentonite 4 Other <b>bentonite hole plug</b> Grout Intervals: From <b>0</b> ft. to <b>5</b> ft. From <b>ft. to</b> <b>ft. From</b> <b>5</b> ft. to <b>21</b> ft. What is the nearest source of possible contamination: 1 Septic tank 4 Lateral lines 7 Pit privy 10 Livestock pens 14 Abandon water well 2 Sewer lines 5 Cess pool 8 Sewage lagoon 11 Fuel storage 15 Oil well/Gas well 3 Watertight sewer lines 6 Seepage pit 9 Feedyard 12 Fertilizer storage 16 Other (specify below) 13 Insecticide storage Direction from well? <b>South</b> How many feet? <b>15</b>									
FROM TO LITHOLOGIC LOG FROM TO PLUGGING INTERVALS									
		0 5 cement grout							
		5 21 bentonite hole plug							
		21 24 chlorinated sand and gravel							
7 CONTRACTOR'S OR LANDOWNER'S CERTIFICATION: This water well was (1) constructed, (2) reconstructed, or (3) plugged under my jurisdiction and was completed on (mo/day/year) <b>08/30/1999</b> and this record is true to the best of my knowledge and belief. Kansas Water Well Contractor's License No. <b>236</b> This Water Well Record was completed on (mo/day/yr) <b>09/01/99</b> Under the business name of <b>Harp Well &amp; Pump Service, Inc</b> by (signature) <b>Todd S. Harp</b>									