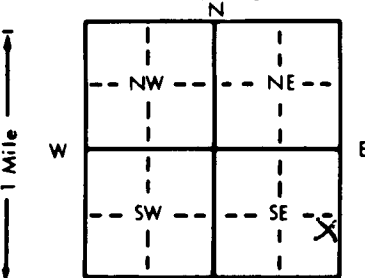


1 LOCATION OF WATER WELL:		Fraction		Section Number		Township Number		Range Number	
County: Sedgwick		NE 1/4 SE 1/4 SE 1/4		31		T 27 S		R 1 E/W	
Distance and direction from nearest town or city street address of well if located within city?									
9' W of Seneca Ave. 315' S of Lydia, Wichita									
2 WATER WELL OWNER: City of Wichita									
RR#, St. Address, Box # : 1900 E 9th									
City, State, ZIP Code : Wichita, KS 67214									
Board of Agriculture, Division of Water Resources									
Application Number:									
3 LOCATE WELL'S LOCATION WITH AN "X" IN SECTION BOX:		4 DEPTH OF COMPLETED WELL: 35.06 ft. ELEVATION:							
		Depth(s) Groundwater Encountered 1. 15.2 ft. 2. ft. 3. ft.							
		WELL'S STATIC WATER LEVEL 15.19 ft. below land surface measured on mo/day/yr							
		Pump test data: Well water was ft. after hours pumping gpm							
		Est. Yield gpm: Well water was ft. after hours pumping gpm							
		Bore Hole Diameter 2.125 in. to 36 ft., and in. to ft.							
		WELL WATER TO BE USED AS:							
		5 Public water supply 8 Air conditioning 11 Injection well							
		1 Domestic 3 Feedlot 6 Oil field water supply 9 Dewatering 12 Other (Specify below)							
		2 Irrigation 4 Industrial 7 Lawn and garden only 10 Monitoring well							
		Was a chemical/bacteriological sample submitted to Department? Yes No X; If yes, mo/day/yr sample was submitted							
		Water Well Disinfected? Yes No X							
5 TYPE OF BLANK CASING USED:									
1 Steel 3 RMP (SR) 5 Wrought iron 8 Concrete tile CASING JOINTS: Glued Clamped									
2 PVC 4 ABS 6 Asbestos-Cement 9 Other (specify below) Welded									
7 Fiberglass Threaded X									
Blank casing diameter 3/4 in. to 25.46 ft., Dia in. to ft., Dia in. to ft.									
Casing height above land surface 10.3 in., weight lbs./ft. Wall thickness or gauge No. Sch 80									
TYPE OF SCREEN OR PERFORATION MATERIAL:									
1 Steel 3 Stainless steel 5 Fiberglass 8 RMP (SR) 10 Asbestos-cement									
2 Brass 4 Galvanized steel 6 Concrete tile 9 ABS 11 Other (specify)									
12 None used (open hole)									
SCREEN OR PERFORATION OPENINGS ARE:									
1 Continuous slot 2 Mill slot 5 Gauzed wrapped 8 Saw cut 11 None (open hole)									
2 Louvered shutter 4 Key punched 6 Wire wrapped 9 Drilled holes									
7 Torch cut 10 Other (specify)									
SCREEN-PERFORATED INTERVALS: From 25.46 ft. to 35.23 ft., From ft. to ft.									
From ft. to ft., From ft. to ft.									
GRAVEL PACK INTERVALS: From 22.4 ft. to 36 ft., From ft. to ft.									
From ft. to ft., From ft. to ft.									
6 GROUT MATERIAL:									
1 Neat cement 2 Cement grout 3 Bentonite 4 Other									
Grout Intervals: From 6.8 ft. to 22.4 ft., From ft. to ft., From ft. to ft.									
What is the nearest source of possible contamination:									
1 Septic tank 4 Lateral lines 7 Pit privy 10 Livestock pens 14 Abandoned water well									
2 Sewer lines 5 Cess pool 8 Sewage lagoon 11 Fuel storage 15 Oil well/Gas well									
3 Watertight sewer lines 6 Seepage pit 9 Feedyard 12 Fertilizer storage 16 Other (specify below)									
Utilih Lines									
Direction from well? How many feet?									
FROM TO LITHOLOGIC LOG FROM TO PLUGGING INTERVALS									
NA									
7 CONTRACTOR'S OR LANDOWNER'S CERTIFICATION: This water well was (1) constructed, (2) reconstructed, or (3) plugged under my jurisdiction and was completed on (mo/day/year) 10-7-99 and this record is true to the best of my knowledge and belief. Kansas Water Well Contractor's License No. 604 This Water Well Record was completed on (mo/day/yr) 10-29-99 under the business name of Environmental Priority Service, Inc. by (signature) [Signature]									
INSTRUCTIONS: Use typewriter or ball point pen. PLEASE PRESS FIRMLY and PRINT clearly. Please fill in blanks, underline or circle the correct answers. Send top three copies to Kansas Department of Health and Environment, Bureau of Water, Topeka, Kansas 66620-0001. Telephone: 913-296-5545. Send one to WATER WELL OWNER and retain one for your records.									