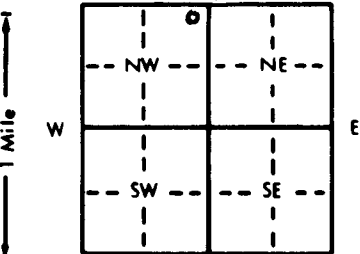


1) LOCATION OF WATER WELL: County: Sedgewick		Fraction NE 1/4 NE 1/4 NW 1/4	Section Number 36	Township Number T 27	Range Number R 1	EW
Distance and direction from nearest town or city street address of well if located within city? 5611 East Harry, Wichita, Ks.						
2) WATER WELL OWNER: RR#, St. Address, Box # City, State, ZIP Code		Bencor Corp. 90 S. Cascade Ave. Suite 330 Colorado Springs, Co			Board of Agriculture, Division of Water Resources Application Number:	
3) LOCATE WELL'S LOCATION WITH AN "X" IN SECTION BOX: 		4) DEPTH OF COMPLETED WELL. 37 1/2 ft. ELEVATION: Depth(s) Groundwater Encountered 1. ft. 2. ft. 3. ft. WELL'S STATIC WATER LEVEL ft. below land surface measured on mo/day/yr Pump test data: Well water was ft. after hours pumping gpm Est. Yield gpm: Well water was ft. after hours pumping gpm Bore Hole Diameter in. to ft. and in. to ft. WELL WATER TO BE USED AS: 1 Domestic 3 Feedlot 6 Oil field water supply 9 Dewatering 12 Other (Specify below) 2 Irrigation 4 Industrial 7 Lawn and garden only 10 Monitoring well Was a chemical/bacteriological sample submitted to Department? Yes No X; If yes, mo/day/yr sample was submitted Water Well Disinfected? Yes No				
5) TYPE OF BLANK CASING USED: 1 Steel 3 RMP (SR) 2 PVC 4 ABS		5 Wrought iron 8 Concrete tile 6 Asbestos-Cement 9 Other (specify below) 7 Fiberglass		CASING JOINTS: Glued Clamped Welded X Threaded Blank casing diameter in. to ft. Dia in. to ft. Dia in. to ft. Dia in. to ft. Casing height above land surface in. weight lbs./ft. Wall thickness or gauge No. SDR 13 SCF 40		
TYPE OF SCREEN OR PERFORATION MATERIAL: 1 Steel 3 Stainless steel 5 Fiberglass 7 PVC 10 Asbestos-cement 2 Brass 4 Galvanized steel 6 Concrete tile 8 RMP (SR) 11 Other (specify) 9 ABS 12 None used (open hole)		SCREEN OR PERFORATION OPENINGS ARE: 1 Continuous slot 3 Mill slot 5 Gauzed wrapped 8 Saw cut 11 None (open hole) 2 Louvered shutter 4 Key punched 6 Wire wrapped 9 Drilled holes 7 Torch cut 10 Other (specify)				
SCREEN-PERFORATED INTERVALS: From ft. to ft. From ft. to ft. From ft. to ft. From ft. to ft.		GRAVEL PACK INTERVALS: From ft. to ft. From ft. to ft. From ft. to ft. From ft. to ft.				
6) GROUT MATERIAL: Grout Intervals: From 37 1/2 ft. to 1' ft. From 1' ft. to 0' ft. From ft. to ft. From ft. to ft.		1 Neat cement 2 Cement grout 3 Bentonite 4 Other What is the nearest source of possible contamination: 1 Septic tank 4 Lateral lines 7 Pit privy 10 Livestock pens 14 Abandoned water well 2 Sewer lines 5 Cess pool 8 Sewage lagoon 11 Fuel storage 15 Oil well/Gas well 3 Watertight sewer lines 6 Seepage pit 9 Feedyard 12 Fertilizer storage 16 Other (specify below) 13 Insecticide storage Direction from well? How many feet?				
FROM	TO	LITHOLOGIC LOG		FROM	TO	PLUGGING INTERVALS
		Flush Hauler roadway was removed 2" PVC pipe filled with bentonite 37 1/2' - 3' Drilled out top 3' of 2" PVC w/ 8 1/2" OD Auger Filled hole 3' - 1' w/ bentonite Cement 1' - 0'				
						Well was abandoned per ok'd by Don Taylor 11-17-99
7) CONTRACTOR'S OR LANDOWNER'S CERTIFICATION: This water well was (1) constructed, (2) reconstructed, or (3) plugged under my jurisdiction and was completed on (mo/day/year) 11-17-99 and this record is true to the best of my knowledge and belief. Kansas Water Well Contractor's License No. 539 This Water Well Record was completed on (mo/day/yr) 12-4-99 under the business name of JB Environmental Drilling by (signature) James Beebe						
INSTRUCTIONS: Use typewriter or ball point pen. PLEASE PRESS FIRMLY and PRINT clearly. Please fill in blanks, underline or circle the correct answers. Send top three copies to Kansas Department of Health and Environment, Bureau of Water, Topeka, Kansas 66620-0001. Telephone: 913-296-5545. Send one to WATER WELL OWNER and retain one for your records.						