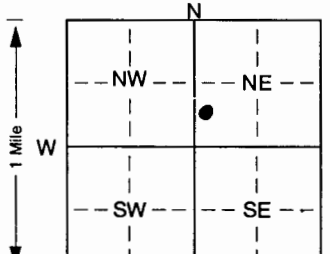


## WATER WELL RECORD Form WWC-5 KSA 82a-1212 ID No.

1 LOCATION OF WATER WELL: County: <b>Sedgwick</b>		FRACTION: <b>NW 1/4 SW 1/4 NE 1/4</b>		SECTION NUMBER: <b>6</b>		TOWNSHIP NUMBER: <b>T 27 S</b>		RANGE NUMBER: <b>R 1 E</b>	
Distance and direction from nearest town or city street address of well if located within city? <b>2700 N. Amidon, Wichita, KS.</b>									
2 WATER WELL OWNER: RR#, St. Address, Box # : City, State, ZIP Code :		<b>Kansas Inc./Citgo</b> <b>2700 N. Amidon</b> <b>Wichita, KS.</b>				Board of Agriculture, Division of Water Resources Application Number:			
3 LOCATE WELL'S LOCATION WITH AN "X" IN SECTION BOX: 		4 DEPTH OF COMPLETED WELL: <b>20'</b> ft. ELEVATION: Depth(s) Groundwater Encountered <b>1. 14'</b> ft. 2. . ft. 3. . ft. WELL'S STATIC WATER LEVEL <b>13.35</b> ft. below land surface measured on mo/day/yr <b>1-6-00</b> Pump test data: Well water was . ft. after . hours pumping . gpm Est. Yield . gpm: Well water was . ft. after . hours pumping . gpm Bore Hole Diameter <b>8 1/2"</b> in. to <b>20'</b> ft., and . in. to . ft. WELL WATER TO BE USED AS: 5 Public water supply 8 Air conditioning 11 Injection well 1 Domestic 3 Feedlot 6 Oil field water supply 9 Dewatering 12 Other (Specify below) 2 Irrigation 4 Industrial 7 Domestic (lawn & garden) 10 Monitoring well Was a chemical/bacteriological sample submitted to Department? Yes. . No. <b>X</b> ; If yes, mo/day/yr sample was submitted Water Well Disinfected? Yes . No <b>(X)</b>							
5 TYPE OF BLANK CASING USED: 1 Steel 3 RMP (SR) 5 Wrought iron 8 Concrete tile CASING JOINTS: Glued. . Clamped. . <b>2 PVC</b> 4 ABS 6 Asbestos-Cement 9 Other (specify below) Welded . <b>X</b> Blank casing diameter <b>2.375</b> in. to <b>10'</b> ft., Dia . in. to . ft., Dia . in. to <b>SDR 13</b> Casing height above land surface <b>Flush</b> in., weight . lbs./ft. Wall thickness or gauge No. <b>SCH 40</b> TYPE OF SCREEN OR PERFORATION MATERIAL: 1 Steel 3 Stainless steel 5 Fiberglass <b>7 PVC</b> 10 Asbestos-cement 2 Brass 4 Galvanized steel 6 Concrete tile 8 RMP (SR) 11 Other (specify) . 9 ABS 12 None used (open hole) SCREEN OR PERFORATION OPENINGS ARE: 1 Continuous slot <b>3 Mill slot</b> 5 Gauzed wrapped 8 Saw cut 11 None (open hole) 2 Louvered shutter 4 Key punched 6 Wire wrapped 9 Drilled holes 7 Torch cut 10 Other (specify) . ft. SCREEN-PERFORATED INTERVALS: From <b>20'</b> ft. to . ft., From . ft. to . ft. GRAVEL PACK INTERVALS: From <b>20'</b> ft. to <b>8'</b> ft., From . ft. to . ft. From . ft. to . ft., From . ft. to . ft.									
6 GROUT MATERIAL: 1 Neat cement 2 Cement grout 3 Bentonite 4 Other . Grout Intervals: From <b>8'</b> ft. to <b>3'</b> ft., From <b>3'</b> ft. to <b>0'</b> ft., From . ft. to . ft. What is the nearest source of possible contamination: 1 Septic tank 4 Lateral lines 7 Pit privy <b>10</b> Livestock pens 14 Abandoned water well 2 Sewer lines 5 Cess pool 8 Sewage lagoon <b>11</b> Fuel storage 15 Oil well/Gas well 3 Watertight sewer lines 6 Seepage pit 9 Feedyard 12 Fertilizer storage 16 Other (specify below) Direction from well? <b>North</b> How many feet? <b>80'</b>									
FROM TO LITHOLOGIC LOG FROM TO PLUGGING INTERVALS <b>0 .50 Asphalt</b> <b>.50 5 Clay, brick, firm, sl moist, odor.</b> <b>5 11 Clay, grn-grn brn, sl moist,</b> <b>firm, non plastic, oxide stained.</b> <b>11 20 Sand, sm-med grained, sub-</b> <b>rounded, poorly sorted,</b> <b>sl-mod odor, wet at 14'.</b> <b>Fl. mt ok'd by Don Taylor</b>									
7 CONTRACTOR'S OR LANDOWNER'S CERTIFICATION: This water well was <b>(1) constructed</b> (2) reconstructed, or (3) plugged under my jurisdiction and was completed on (mo/day/year) <b>12-20-99</b> and this record is true to the best of my knowledge and belief. Kansas Water Well Contractor's Licence No. <b>539</b> This Water Well Record was completed on (mo/day/yr) <b>2-3-00</b> under the business name of <b>JB Environmental Drilling</b> by (signature) <b>James Becker</b>									
INSTRUCTIONS: Use typewriter or ball point pen. PLEASE PRESS FIRMLY and PRINT clearly. Please fill in blanks, underline or circle the correct answer. Send top three copies to Kansas Department of Health and Environment, Bureau of Water, Topeka, Kansas 66620-0001. Telephone 785-296-5524. Send one to WATER WELL OWNER and retain one for your records. Fee of \$5.00 for each constructed well.									