(3)

WATER WELL RECORD Form WWC-5 KSA 82a-1212 ID No. _____

1 LOCATION OF WATER WELL:	Fraction	Section Number	Township Number	Range Number
County: Sedgwick	NE ¼ NE ¼ SE ¼	21	T 27 S	R 1 (E) W

Distance and direction from nearest town or city street address of well if located within city?
1520 East Douglas Ave., Wichita, KS.

2 WATER WELL OWNER: SHD Motors
RR#, St. Address, Box # : 1520 E. Douglas Ave.
City, State, ZIP Code : Wichita, KS.

Board of Agriculture, Division of Water Resources Application Number:

3 LOCATE WELL'S LOCATION WITH AN "X" IN SECTION BOX:

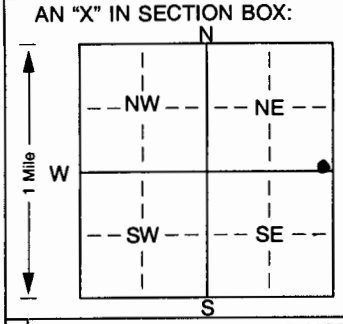

4 DEPTH OF COMPLETED WELL 20 ft. ELEVATION:
Depth(s) Groundwater Encountered 12.65 12½ ft. 2. ft. 3. 6/15/00 ft.
WELL'S STATIC WATER LEVEL 12.65 ft. below land surface measured on mo/day/yr 6/15/00
Pump test data: Well water was ft. after hours pumping gpm
Est. Yield gpm Well water was ft. after hours pumping gpm
Bore Hole Diameter 8½ in. to 20 ft., and in. to ft.
WELL WATER TO BE USED AS: 5 Public water supply 8 Air conditioning 11 Injection well
1 Domestic 3 Feedlot 6 Oil field water supply 9 Dewatering 12 Other (Specify below)
2 Irrigation 4 Industrial 7 Domestic (lawn & garden) 10 Monitoring well
Was a chemical/bacteriological sample submitted to Department? Yes No ; If yes, mo/day/yrs sample was submitted
Water Well Disinfected? Yes (No)

5 TYPE OF BLANK CASING USED: 5 Wrought iron 8 Concrete tile CASING JOINTS: Glued Clamped
1 Steel 3 RMP (SR) 6 Asbestos-Cement 9 Other (specify below) Welded
(2 PVC) 4 ABS 7 Fiberglass Threaded
Blank casing diameter 2 3/8 in. to 10 ft., Dia in. to ft., Dia in. to X ft.
Casing height above land surface FLUSH MOUNT in., weight lbs./ft. Wall thickness or gauge No. SDR 13 SCH 40
TYPE OF SCREEN OR PERFORATION MATERIAL: (7 PVC) 10 Asbestos-cement
1 Steel 3 Stainless steel 5 Fiberglass 8 RMP (SR) 11 Other (specify)
2 Brass 4 Galvanized steel 6 Concrete tile 9 ABS 12 None used (open hole)
SCREEN OR PERFORATION OPENINGS ARE: 5 Gauzed wrapped 8 Saw cut 11 None (open hole)
1 Continuous slot (3 Mill slot) 6 Wire wrapped 9 Drilled holes
2 Louvered shutter 4 Key punched 7 Torch cut 10 Other (specify) ft.
SCREEN-PERFORATED INTERVALS: From 20 ft. to 10 ft., From ft. to ft.
From 20 ft. to Y ft., From ft. to ft.
GRAVEL PACK INTERVALS: From 20 ft. to Y ft., From ft. to ft.
From ft. to ft., From ft. to ft.

6 GROUT MATERIAL: 1 Neat cement (2) Cement grout (3) Bentonite 4 Other
Grout Intervals: From 0 ft. to 3 ft., From 3 ft. to Y ft., From ft. to ft.
What is the nearest source of possible contamination: 10 Livestock pens 14 Abandoned water well
1 Septic tank 4 Lateral lines 7 Pit privy (11) Fuel storage 15 Oil well/Gas well
2 Sewer lines 5 Cess pool 8 Sewage lagoon 12 Fertilizer storage 16 Other (specify below)
3 Watertight sewer lines 6 Seepage pit 9 Feedyard 13 Insecticide storage
Direction from well? WEST - NORTHWEST How many feet? 105

FROM	TO	LITHOLOGIC LOG	FROM	TO	PLUGGING INTERVALS
0	.50	Asphalt			
.50	6	Gravel, dirt fill.			
		clay, very firm, no odor.			
6	12	Clay, brn/gray, very firm,			
		oxides, gray stringers, no odor.			
12	15	Gray/blk sand, fine, well			
		sorted, sub rounded, wet at 12'			
15	20	Brn-tan sand, med-cse gr,			
		sub rounded, no odor.			
					Fl. mt. ok'd by Don Taylor

7 CONTRACTOR'S OR LANDOWNER'S CERTIFICATION: This water well was (1) (constructed) (2) reconstructed, or (3) plugged under my jurisdiction and was completed on (mo/day/year) 6-15-00 and this record is true to the best of my knowledge and belief. Kansas Water Well Contractor's Licence No. 538 This Water Well Record was completed on (mo/day/yr) 7-7-00
under the business name of JB Enviromental Drilling by (signature) James Bieker

INSTRUCTIONS: Use typewriter or ball point pen. *PLEASE PRESS FIRMLY* and *PRINT* clearly. Please fill in blanks, underline or circle the correct answers. Send top three copies to Kansas Department of Health and Environment, Bureau of Water, Topeka, Kansas 66620-0001. Telephone 785-296-5524. Send one to WATER WELL OWNER and retain one for your records. Fee of $5.00 for each constructed well.