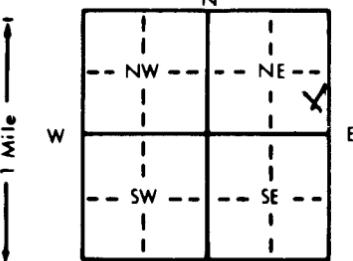


1 LOCATION OF WATER WELL: County: <u>Sedgewick</u> Fraction <u>NE 1/4 SE 1/4 NE 1/4</u> Section Number <u>19</u> Township Number <u>T 27 S</u> Range Number <u>R 1 E</u>	
Distance and direction from nearest town or city street address of well if located within city? <u>403 N. Seneca Wichita</u>	
2 WATER WELL OWNER: <u>BDAT Environmental Inc. (Outlet Corp.)</u> RR#, St. Address, Box #: <u>1862 Craigshire</u> City, State, ZIP Code: <u>St. Louis, MO 63146</u> Board of Agriculture, Division of Water Resources Application Number: <u>901 N. Lincoln Tulsa, OK 74101</u>	
3 LOCATE WELL'S LOCATION WITH AN "X" IN SECTION BOX: 	4 DEPTH OF COMPLETED WELL: <u>21</u> ft. ELEVATION: <u>1297.91</u> Depth(s) Groundwater Encountered: <u>1</u> ft. <u>16</u> ft. <u>3</u> ft. <u>ft.</u> WELL'S STATIC WATER LEVEL: <u>1390</u> ft. below land surface measured on mo/day/yr <u>1-12-95</u> Pump test data: Well water was <u>NA</u> ft. after <u>NA</u> hours pumping <u>gpm</u> Est. Yield <u>NA</u> gpm: Well water was <u>NA</u> ft. after <u>NA</u> hours pumping <u>gpm</u> Bore Hole Diameter: <u>8</u> in. to <u>21</u> ft. and <u>in.</u> to <u>ft.</u> WELL WATER TO BE USED AS: 1 Domestic 3 Feedlot 6 Oil field water supply 9 Dewatering 12 Other (Specify below) 2 Irrigation 4 Industrial 7 Lawn and garden only <u>10 Monitoring well</u> <u>MW-1</u> Was a chemical/bacteriological sample submitted to Department? Yes <u>No</u> If yes, mo/day/yr sample was submitted <u>No</u> Water Well Disinfected? Yes <u>No</u>
5 TYPE OF BLANK CASING USED: 1 Steel 3 RMP (SR) 5 Wrought iron 8 Concrete tile CASING JOINTS: Glued <u>Clamped</u> <u>2 PVC</u> 4 ABS 6 Asbestos-Cement 9 Other (specify below) <u>Welded</u> Blank casing diameter <u>2</u> in. to <u>11</u> ft. Dia <u>in.</u> to <u>ft.</u> Dia <u>in.</u> to <u>ft.</u> Casing height above land surface <u>0</u> in., weight <u>lb./ft.</u> Wall thickness or gauge No. <u>40</u> TYPE OF SCREEN OR PERFORATION MATERIAL: 1 Steel 3 Stainless steel 5 Fiberglass <u>7 PVC</u> 10 Asbestos-cement 2 Brass 4 Galvanized steel 6 Concrete tile 8 RMP (SR) 11 Other (specify) SCREEN OR PERFORATION OPENINGS ARE: 1 Continuous slot <u>3 Mill slot</u> 5 Gauzed wrapped 8 Saw cut 11 None (open hole) 2 Louvered shutter 4 Key punched 6 Wire wrapped 9 Drilled holes SCREEN-PERFORATED INTERVALS: From <u>21</u> ft. to <u>11</u> ft. From <u>ft.</u> to <u>ft.</u> GRAVEL PACK INTERVALS: From <u>21</u> ft. to <u>8.5</u> ft. From <u>ft.</u> to <u>ft.</u> From <u>ft.</u> to <u>ft.</u> From <u>ft.</u> to <u>ft.</u>	
6 GROUT MATERIAL: 1 Neat cement <u>2 Cement grout</u> <u>3 Bentonite</u> 4 Other Grout Intervals: From <u>0</u> ft. to <u>1</u> ft. From <u>1</u> ft. to <u>8.5</u> ft. From <u>ft.</u> to <u>ft.</u> What is the nearest source of possible contamination: 1 Septic tank 4 Lateral lines 7 Pit privy <u>10 Livestock pens</u> 14 Abandoned water well 2 Sewer lines 5 Cess pool 8 Sewage lagoon <u>11 Fuel storage</u> 15 Oil well/Gas well 3 Watertight sewer lines 6 Seepage pit 9 Feedyard 12 Fertilizer storage 16 Other (specify below) Direction from well? <u>SE</u> How many feet? <u>35'</u> FROM TO LITHOLOGIC LOG FROM TO PLUGGING INTERVALS <u>0 0.5 Asphalt</u> <u>0.5 1.5 Silty clay</u> <u>1.5 21 Sand</u> <u>0 20 Chip Bentonite</u>	
7 CONTRACTOR'S OR LANDOWNER'S CERTIFICATION: This water well was (1) constructed, (2) reconstructed, or <u>(3) plugged</u> under my jurisdiction and was completed on (mo/day/year) <u>5/19/00</u> and this record is true to the best of my knowledge and belief. Kansas Water Well Contractor's License No. <u>634</u> This Water Well Record was completed on (mo/day/yr) <u>8/22/00</u> under the business name of <u>Shirley Enviro</u> by (signature) <u>Charles Engle</u>	
INSTRUCTIONS: Use typewriter or ball point pen. PLEASE PRESS FIRMLY and PRINT clearly. Please fill in blanks, underline or circle the correct answers. Send top three copies to Kansas Department of Health and Environment, Bureau of Water, Topeka, Kansas 66620-0001. Telephone: 913-296-5545. Send one to WATER WELL OWNER and retain one for your records.	