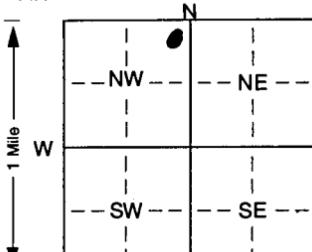


1 LOCATION OF WATER WELL:		Fraction		Section Number		Township Number		Range Number			
County: Sedgwick		NE ¼ NE ¼ NW ¼		36		T 27 S R 1 E					
Distance and direction from nearest town or city street address of well if located within city? Harry & Edgemor Street, Wichita, KS. 5601 E. Harry, Wichita											
2 WATER WELL OWNER Walgreen's Inc. RR#, St. Address, Box # Harry & Edgemor City, State, ZIP Code Wichita, KS. <div style="text-align: right;">Board of Agriculture, Division of Water Resources Application Number:</div>											
3 LOCATE WELL'S LOCATION WITH			4 DEPTH OF COMPLETED WELL 20' ft. ELEVATION:								
AN "X" IN SECTION BOX: <div style="text-align: center;"></div>			Depth(s) Groundwater Encountered 14' ft. 2. ft. 3. ft. WELL'S STATIC WATER LEVEL 13.31 ft. below land surface measured on mo/day/yr 5-24-00 Pump test data: Well water was ft. after hours pumping gpm Est. Yield gpm; Well water was ft. after hours pumping gpm Bore Hole Diameter 8 1/2" in. to 20' ft., and in. to ft. WELL WATER TO BE USED AS: 5 Public water supply 8 Air conditioning 11 Injection well 1 Domestic 3 Feedlot 6 Oil field water supply 9 Dewatering 12 Other (Specify below) 2 Irrigation 4 Industrial 7 Domestic (lawn & garden) 10 Monitoring well Was a chemical/bacteriological sample submitted to Department? Yes. No. X ; If yes, mo/day/yrs sample was submitted Water Well Disinfected? Yes No (No)								
5 TYPE OF BLANK CASING USED: 1 Steel 3 RMP (SR) 5 Wrought iron 8 Concrete tile CASING JOINTS: Glued. Clamped. 2 PVC 4 ABS 6 Asbestos-Cement 9 Other (specify below) Welded Blank casing diameter 2.375 in. to 10' ft., Dia in. to ft., Dia in. to SDR 13 ft. Casing height above land surface Flush Mt. in., weight lbs./ft. Wall thickness or gauge No. SCH 40 TYPE OF SCREEN OR PERFORATION MATERIAL: 7 PVC 10 Asbestos-cement 1 Steel 3 Stainless steel 5 Fiberglass 8 RMP (SR) 11 Other (specify) 2 Brass 4 Galvanized steel 6 Concrete tile 9 ABS 12 None used (open hole) SCREEN OR PERFORATION OPENINGS ARE: 1 Continuous slot 3 Mill slot 5 Gauzed wrapped 8 Saw cut 11 None (open hole) 2 Louvered shutter 4 Key punched 6 Wire wrapped 9 Drilled holes SCREEN-PERFORATED INTERVALS: From 20' ft. to 10' ft., From ft. to ft. GRAVEL PACK INTERVALS: From 20' ft. to 8' ft., From ft. to ft. From ft. to ft., From ft. to ft.											
6 GROUT MATERIAL: 1 Neat cement 2 Cement grout 3 Bentonite 4 Other Grout Intervals: From 8' (3) ft. to 3' (2) ft., From 3' (2) ft. to 0' (2) ft., From ft. to ft. What is the nearest source of possible contamination: 1 Septic tank 4 Lateral lines 7 Pit privy 10 Livestock pens 14 Abandoned water well 2 Sewer lines 5 Cess pool 8 Sewage lagoon 11 Fuel storage 15 Oil well/Gas well 3 Watertight sewer lines 6 Seepage pit 9 Feedyard 12 Fertilizer storage 16 Other (specify below) Direction from well? North East How many feet? 400											
FROM		TO		LITHOLOGIC LOG		FROM		TO		PLUGGING INTERVALS	
0		6		Brn-lt brn silty clay, moist to dry, no odor, firm.							
6		15		Lt red brn clay, moist, firm, no odor, trace of sand at 10-15'.							
15		20		Brn fine-coarse sand, wet, no odor, poorly sorted.							
F1 mt ok'd by Don Taylor											
7 CONTRACTOR'S OR LANDOWNER'S CERTIFICATION: This water well was (1) constructed, (2) reconstructed, or (3) plugged under my jurisdiction and was completed on (mo/day/year) 5-24-00 539 and this record is true to the best of my knowledge and belief. Kansas Water Well Contractor's Licence No. JB Environmental Drilling . This Water Well Record was completed on (mo/day/yr) 6-12-00 under the business name of James Becker by signature James Becker											
INSTRUCTIONS: Use typewriter or ball point pen. PLEASE PRESS FIRMLY and PRINT clearly. Please fill in blanks, underline or circle the correct answers. Send top three copies to Kansas Department of Health and Environment, Bureau of Water, Topeka, Kansas 66620-0001. Telephone 785-296-5524. Send one to WATER WELL OWNER and retain one for your records. Fee of \$5.00 for each constructed well.											