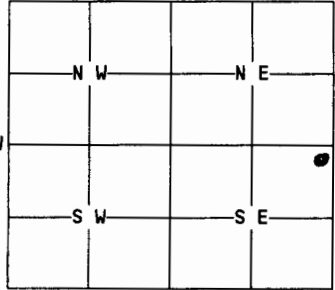


1 LOCATION OF WATER WELL: County: <u>Sedgwick</u>	Fraction <u>NE 1/4 NE 1/4 SE 1/4</u>	Section Number <u>21</u>	Township Number <u>27</u>	Range Number <u>1 E</u>
--	---	-----------------------------	------------------------------	----------------------------

Distance and direction from nearest town or city street address of well if located within city?
Intown

2 WATER WELL OWNER: <u>SHD Motors</u> RR#, St. Address, Box #: <u>1520 E. Douglas Ave.</u> City, State, ZIP Code: <u>Wichita, KS 67207</u>	Board of Agriculture, Division of Water Resources Application Number:
--	--

3 MARK WELL'S LOCATION WITH AN "X" IN SECTION BOX: N  S	4 DEPTH OF WELL..... <u>20'</u>ft. WELL'S STATIC WATER LEVEL..... <u>12.8'</u>ft. WELL WAS USED AS: <div style="display: flex; justify-content: space-between;"> <div> 1 Domestic 2 Irrigation 3 Feedlot 4 Industrial </div> <div> 5 Public Water Supply 6 Oil Field Water Supply 7 Lawn and Garden Only 8 Air Conditioning </div> <div> 9 Dewatering 10 Monitoring Well 11 Injection Well 12 Other..... </div> </div> <p>Was a chemical/bacteriological sample submitted to Department? Yes.....No.....<input checked="" type="checkbox"/> If yes, mo/day/yr sample was submitted..... Water Well Disinfected: Yes..... No.....<input checked="" type="checkbox"/></p>
--	--

5 TYPE OF BLANK CASING USED:				
1 Steel	3 RMP (SR)	5 Wrought	7 Fiberglass	9 Other (specify below)
<input checked="" type="checkbox"/> 2 PVC	4 ABS	6 Asbestos-Cement	8 Concrete Tile	
Blank casing diameter <u>2.375</u> in. Was casing pulled? Yes <input checked="" type="checkbox"/> No..... If yes, how much <u>20' TD</u> Casing height above or below land surface... <u>N/A</u>in.				

6 GROUT PLUG MATERIAL: 1 Neat cement ② Cement grout ③ Bentonite 4 Other.....				
Grout Plug Intervals: From <u>20'</u> ft. to <u>1'</u> ft., From <u>1'</u> ft. to <u>0'</u> ft., From..... to.....ft.				
What is the nearest source of possible contamination: ③				
1 Septic tank	6 Seepage pit	① Fuel storage	16 Other (specify below)	
② Sewer lines	7 Pit privy	12 Fertilizer storage		
3 Watertight sewer lines	8 Sewage lagoon	13 Insecticide storage		
4 Lateral lines	9 Feedyard	14 Abandoned water well		
5 Cess Pool	10 Livestock pens	15 Oil well/Gas well		
Direction from well? <u>North</u> How many feet? <u>165</u>				

FROM	TO	PLUGGING MATERIALS
<u>20'</u>	<u>1'</u>	<u>Bentonite</u>
<u>1'</u>	<u>0'</u>	<u>Cement</u>

7 CONTRACTOR'S OR LANDOWNER'S CERTIFICATION: This water well was plugged under my jurisdiction and was completed on (mo/day/year) <u>8-30-00</u> and this record is true to the best of my knowledge and belief. Kansas Water Well Contractor's License No. <u>539</u> This Water Well Record was completed on (mo/day/year) <u>9-3-00</u> under the business name of <u>88 Environmental</u> by (signature) <u>James Burke</u>	
--	--

INSTRUCTIONS: Use typewriter or ball point pen. Please press firmly and print clearly. Please fill in blanks, underline or circle the correct answers. Send top three copies to Kansas Department of Health and Environment, Bureau of Water, Topeka, Kansas 66620-0001. Telephone: 785/296-3565. Send one to Water Well Owner and retain one for your records.