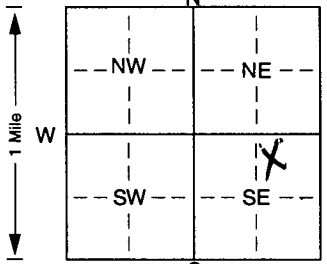


007242

WATER WELL RECORD Form WWC-5 KSA 82a-1212 ID No.

1 LOCATION OF WATER WELL:		Fraction	Section Number	Township Number	Range Number
County: <u>Sedgwick</u>		<u>NW 1/4 NE 1/4 SE 1/4</u>	<u>4</u>	T <u>27</u> S	R <u>1</u> <u>EW</u>
Distance and direction from nearest town or city, street address of well if located within city? <u>2549 N. New York</u>					
2 WATER WELL OWNER:					
RR#, St. Address, Box # : <u>Safety-Kleen, Inc.</u> City, State, ZIP Code : <u>5665 Flatiron Pkwy</u> <u>Boulder CO 80301</u>					
Board of Agriculture, Division of Water Resources Application Number:					
to <u>38</u> ft. WELL WATER TO BE USED AS: 5 Public water supply 8 Air conditioning 11 Injection well 1 Domestic 3 Feedlot 6 Oil field water supply 9 Dewatering 12 Other (Specify below) 2 Irrigation 4 Industrial 7 Domestic (lawn & garden) <u>10 Monitoring well</u> <u>SK-21</u>			
Was a chemical/bacteriological sample submitted to Department? Yes. <u>X</u> ; If yes, mo/day/yr sample was submitted Water Well Disinfected? Yes <u>X</u> No <u>X</u>					
5 TYPE OF BLANK CASING USED:					
1 Steel 3 RMP (SR) 5 Wrought iron 8 Concrete tile CASING JOINTS: Glued. <u>Clamped.</u> 2 PVC 4 ABS 6 Asbestos-Cement 9 Other (specify below) Welded <u>Flush</u> Blank casing diameter <u>2</u> in. to <u>33</u> ft., Dia <u>2</u> in. to <u>33</u> ft., Dia <u>2</u> in. to <u>33</u> ft., Dia <u>2</u> in. to <u>33</u> ft. Casing height above land surface. <u>Flush</u> in., weight <u>703</u> lbs./ft. Wall thickness or gauge No. <u>Sch 40</u>					
TYPE OF SCREEN OR PERFORATION MATERIAL:					
1 Steel 3 Stainless steel 5 Fiberglass 7 PVC 10 Asbestos-cement 2 Brass 4 Galvanized steel 6 Concrete tile 8 RMP (SR) 11 Other (specify) SCREEN OR PERFORATION OPENINGS ARE: 3 Mill slot 11 None (open hole) 1 Continuous slot 4 Key punched 7 Torch cut 10 Other (specify) <u>10</u> ft. 2 Louvered shutter 6 Wire wrapped 9 Drilled holes SCREEN-PERFORATED INTERVALS: From <u>33</u> ft. to <u>38</u> ft., GRAVEL PACK INTERVALS: From <u>30</u> ft. to <u>38</u> ft., 
6 GROUT MATERIAL: 1 Neat cement 2 Cement grout 3 Bentonite 4 Other					
Grout Intervals: From <u>2</u> ft. to <u>30</u> ft., 
What is the nearest source of possible contamination:					
1 Septic tank 4 Lateral lines 7 Pit privy 10 Livestock pens 14 Abandoned water well 2 Sewer lines 5 Cess pool 8 Sewage lagoon 11 Fuel storage 15 Oil well/Gas well 3 Watertight sewer lines 6 Seepage pit 9 Feedyard 12 Fertilizer storage 16 Other (specify below) Direction from well? How many feet?					
FROM	TO	LITHOLOGIC LOG	FROM	TO	PLUGGING INTERVALS
0	3	lean clay			
3	9	lean clay			
9	16	sand			
16	25	sand			
25	27.5	lean clay & silt			
27.5	36.5	sand			
36.5	38	weathered bedrock			
7 CONTRACTOR'S OR LANDOWNER'S CERTIFICATION: This water well was (1) constructed (2) reconstructed, or (3) plugged under my jurisdiction and was completed on (mo/day/year) <u>10/26/00</u> and this record is true to the best of my knowledge and belief. Kansas Water Well Contractor's Licence No. <u>531</u> This Water Well Record was completed on (mo/day/yr) <u>12/6/00</u> under the business name of <u>Geotechnical Services, Inc.</u> by (signature) <u>Allen M. Smith</u>					
INSTRUCTIONS: Use typewriter or ball point pen. PLEASE PRESS FIRMLY and PRINT clearly. Please fill in blanks, underline or circle the correct answers. Send top three copies to Kansas Department of Health and Environment, Bureau of Water, Topeka, Kansas 66620-0001. Telephone 785-296-5524. Send one to WATER WELL OWNER and retain one for your records. Fee of \$5.00 for each constructed well.					