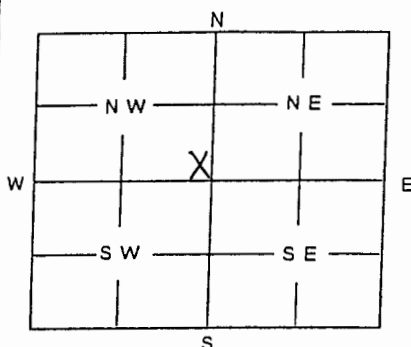


1	LOCATION OF WATER WELL:	Fraction	Section Number	Township Number	Range Number
County:	<u>Reddick</u>	<u>SE 1/4 SE 1/4 NW 1/4</u>	<u>16</u>	<u>T27 S</u>	<u>R1 E</u>

Distance and direction from nearest town or city street address of well if located within city?

260' southwest of the southwest corner of 10th + Mosely2 WATER WELL OWNER: House Oil Co.RR #, St. Address, Box #: 2860 Wedgewood St.
City, State, ZIP Code: Wichita, KansasBoard of Agriculture, Division of Water Resources
Application Number: _____

3 MARK WELL'S LOCATION WITH AN "X" IN SECTION BOX:

4 DEPTH OF WELL 40 ftWELL'S STATIC WATER LEVEL 15 ft.

WELL WAS USED AS:

- | | | |
|--------------|----------------------------|--------------------------|
| 1 Domestic | 5 Public Water Supply | 9 Dewatering |
| 2 Irrigation | 6 Oil Field Water Supply | 10 Monitoring Well |
| 3 Feedlot | 7 Domestic (Lawn & Garden) | 11 Injection Well |
| 4 Industrial | 8 Air Conditioning | 12 Other <u>Recovery</u> |

Was a chemical / bacteriological sample submitted to Department? Yes No ✓
If yes, mo/day/yr sample was submittedWater Well Disinfected: Yes No ✓

5 TYPE OF BLANK CASING USED:

- | | | | | |
|---------|------------|-------------------|-----------------|-------------------------|
| 1 Steel | 3 RMP (SR) | 5 Wrought | 7 Fiberglass | 9 Other (Specify below) |
| 2 PVC | 4 ABS | 6 Asbestos-Cement | 8 Concrete Tile | |

Blank casing diameter 8 in. Was casing pulled? Yes ✓ No If yes, how much 40'
Casing height above or below land surface in.6 GROUT PLUG MATERIAL: 1 Neat cement 2 Cement grout 3 Bentonite 4 OtherGrout Plug Intervals: From 0 ft. to 40 ft. From ft. to ft. From to ft.

What is the nearest source of possible contamination:

- | | | | |
|--------------------------|-------------------|-------------------------|--------------------------|
| 1 Septic tank | 6 Seepage pit | 11 Fuel storage | 16 Other (specify below) |
| 2 Sewer lines | 7 Pit privy | 12 Fertilizer storage | |
| 3 Watertight sewer lines | 8 Sewage lagoon | 13 Insecticide storage | |
| 4 Lateral lines | 9 Feedyard | 14 Abandoned water well | |
| 5 Cess Pool | 10 Livestock pens | 15 Oil well/Gas well | |

Direction from well? North How many feet? 100

FROM	TO	PLUGGING MATERIALS
<u>0</u>	<u>14</u>	<u>Bentonite (14")</u>
<u>14</u>	<u>40</u>	<u>Bentonite (8")</u>

RW2

7 CONTRACTOR'S OR LANDOWNER'S CERTIFICATION: This water well was plugged under my jurisdiction and was completed on (mo/day/year) 11/21/00 and this record is true to the best of my knowledge and belief. Kansas Water Well Contractor's License No. 527 This Water Well Record was completed on (mo/day/year) 12/5/00
by (signature) [Signature] Under the business name of Geotone Services, Inc.

INSTRUCTIONS: Use typewriter or ball point pen. Please press firmly and print clearly. Please fill in blanks, underline or circle the correct answers. Send top three copies to Kansas Department of Health and Environment, Bureau of Water, Topeka, Kansas 66620-0001. Telephone: 785/296-3565. Send one to Water Well Owner and retain one for your records.