

SW NE SE 27 27 1E

WATER WELL RECORD Form WWC-5 KSA 82a-1212

LOCATION OF WATER WELL:	Fraction	Section Number	Township Number	Range Number
County: SEDGWICK	CITY LOT		T S R E/W	

Distance and direction from nearest town or city street address of well if located within city?

WATER WELL OWNER: **ERIC REYES**
 R#, St. Address, Box #: **2126 MENLO**
 City, State, ZIP Code: **WICHITA, KS 67211**

Board of Agriculture, Division of Water Resources
 Application Number:

LOCATE WELL'S LOCATION WITH AN "X" IN SECTION BOX:	DEPTH OF COMPLETED WELL: UNKNOWN ft.	ELEVATION:
	Depth(s) Groundwater Encountered 1. _____ ft. 2. _____ ft. 3. _____ ft. WELL'S STATIC WATER LEVEL 6'-8" ft. below BASEMENT FLOOR measured on mo/day/yr 2-27-01 Pump test data: Well water was _____ ft. after _____ hours pumping _____ gpm Est. Yield _____ gpm: Well water was _____ ft. after _____ hours pumping _____ gpm Bore Hole Diameter _____ in. to _____ ft., and _____ in. to _____ ft.	
	WELL WATER TO BE USED AS: 5 Public water supply 8 Air conditioning 11 Injection well 1 Domestic 3 Feedlot 6 Oil field water supply 9 Dewatering 12 Other (Specify below) 2 Irrigation 4 Industrial 7 Lawn and garden only 10 Monitoring well	
	Was a chemical/bacteriological sample submitted to Department? Yes _____ No _____ If yes, mo/day/yr sample was submitted _____ Water Well Disinfected? Yes _____ No _____	

TYPE OF BLANK CASING USED:	5 Wrought iron	8 Concrete tile	CASING JOINTS: Glued _____ Clamped _____
1 Steel	3 RMP (SR)	6 Asbestos-Cement	9 Other (specify below) _____
2 PVC	4 ABS	7 Fiberglass	_____ NO CASING _____
			Welded _____ Threaded _____

Blank casing diameter _____ in. to _____ ft., Dia _____ in. to _____ ft., Dia _____ in. to _____ ft.
 Casing height above land surface _____ in., weight _____ lbs./ft. Wall thickness or gauge No. _____

TYPE OF SCREEN OR PERFORATION MATERIAL:	7 PVC	10 Asbestos-cement
1 Steel	3 Stainless steel	5 Fiberglass
2 Brass	4 Galvanized steel	6 Concrete tile
	8 RMP (SR)	9 ABS
		11 Other (specify) _____
		12 None used (open hole)

SCREEN OR PERFORATION OPENINGS ARE:	5 Gauzed wrapped	8 Saw cut	11 None (open hole)
1 Continuous slot	3 Mill slot	6 Wire wrapped	9 Drilled holes
2 Louvered shutter	4 Key punched	7 Torch cut	10 Other (specify) _____

SCREEN-PERFORATED INTERVALS:	From _____ ft. to _____ ft., From _____ ft. to _____ ft., From _____ ft. to _____ ft.
GRAVEL PACK INTERVALS:	From _____ ft. to _____ ft., From _____ ft. to _____ ft., From _____ ft. to _____ ft.

6 GROUT MATERIAL:	1 Neat cement	2 Cement grout	3 Bentonite	4 Other _____
Grout Intervals:	From _____ ft. to _____ ft., From _____ ft. to _____ ft., From _____ ft. to _____ ft.			
What is the nearest source of possible contamination:	10 Livestock pens	14 Abandoned water well		
1 Septic tank	4 Lateral lines	7 Pit privy		
2 Sewer lines	5 Cess pool	8 Sewage lagoon		
3 Watertight sewer lines	6 Seepage pit	9 Feedyard		
		11 Fuel storage		
		12 Fertilizer storage		
		13 Insecticide storage		
		15 Oil well/Gas well		
		16 Other (specify below) _____		

Direction from well? _____ How many feet? _____


FROM	TO	LITHOLOGIC LOG	FROM	TO	PLUGGING INTERVALS
0	0.5	1 1/4" DRIVEN PIPE WELL			
		EXPANSIVE CONCRETE GROUT			CUT OFF BELOW FLOOR
					FLUSH W/ BASEMENT FLOOR

RECEIVED

MAR 02 2001

BUREAU OF WATER

NW CORNER OF BASEMENT

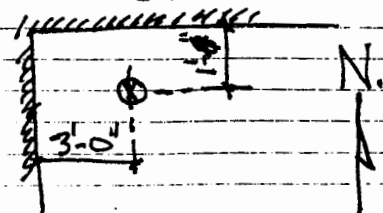

7 CONTRACTOR'S OR LANDOWNER'S CERTIFICATION: This water well was (1) constructed, (2) reconstructed, or (3) plugged under my jurisdiction and was completed on (mo/day/year) 2-27-01 and this record is true to the best of my knowledge and belief. Kansas Water Well Contractor's License No. NONE This Water Well Record was completed on (mo/day/yr) 2-28-01 under the business name of NONE by (signature) Eric Reyes
