

LOCATION OF WATER WELL:	Fraction	Section Number	Township Number	Range Number
County: <u>Sedgwick</u>	<u>NW 1/4 SW 1/4 NE 1/4</u>	<u>9</u>	<u>T 27 S</u>	<u>R 1 E</u>

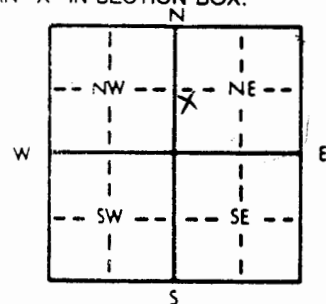
Distance and direction from nearest town or city street address of well if located within city?

3' n of 19th St n and 115' E of OhioWichita, KS mnw-09DWATER WELL OWNER: City of WichitaR#, St. Address, Box #: 1900 E. 9th STREETCity, State, ZIP Code: Wichita, KS 67214

Board of Agriculture, Division of Water Resources

Application Number:

LOCATE WELL'S LOCATION WITH AN "X" IN SECTION BOX:

4 DEPTH OF COMPLETED WELL: 31.6 ft. ELEVATION:Depth(s) Groundwater Encountered 1. 12.4 ft. 2. ft. 3. ft.

WELL'S STATIC WATER LEVEL ft. below land surface measured on mo/day/yr

Pump test data: Well water was ft. after hours pumping gpm

Est. Yield N.A. gpm: Well water was ft. after hours pumping gpmBore Hole Diameter 2 1/8 in. to 33' ft., and in. to ft.

WELL WATER TO BE USED AS: 5 Public water supply 8 Air conditioning 11 Injection well

1 Domestic 3 Feedlot 6 Oil field water supply 9 Dewatering 12 Other (Specify below)

2 Irrigation 4 Industrial 7 Lawn and garden only 10 Monitoring wellWas a chemical/bacteriological sample submitted to Department? Yes No X; If yes, mo/day/yr sample was submittedWater Well Disinfected? Yes No X

TYPE OF BLANK CASING USED:

1 Steel 3 RMP (SR) 5 Wrought iron 8 Concrete tile CASING JOINTS: Glued Clamped

2 PVC 4 ABS 6 Asbestos-Cement 9 Other (specify below) WeldedBlank casing diameter 3/4 in. to 21.5 ft., Dia in. to ft., Dia in. to ft.Casing height above land surface Flush in., weight lbs./ft. Wall thickness or gauge No. SC# 80

TYPE OF SCREEN OR PERFORATION MATERIAL:

1 Steel 3 Stainless steel 5 Fiberglass 7 PVC 10 Asbestos-cement

2 Brass 4 Galvanized steel 6 Concrete tile 8 RMP (SR) 11 Other (specify)

SCREEN OR PERFORATION OPENINGS ARE: 9 ABS 12 None used (open hole)

1 Continuous slot 3 Mill slot 5 Gauzed wrapped 8 Saw cut 11 None (open hole)

2 Louvered shutter 4 Key punched 6 Wire wrapped 9 Drilled holes

GREEN-PERFORATED INTERVALS: From 21.5 ft. to 31.3 ft., From ft. to ft.

From ft. to ft., From ft. to ft.

GRAVEL PACK INTERVALS: From 19.5 ft. to 31.6 ft., From ft. to ft.

From ft. to ft., From ft. to ft.

GROUT MATERIAL: 1 Neat cement 2 Cement grout 3 Bentonite 4 OtherGrout intervals: From 0 ft. to 19.5 ft., From ft. to ft.

What is the nearest source of possible contamination:

1 Septic tank 4 Lateral lines 7 Pit privy 10 Livestock pens 14 Abandoned water well

2 Sewer lines 5 Cess pool 8 Sewage lagoon 11 Fuel storage 15 Oil well/Gas well

3 Watertight sewer lines 6 Seepage pit 9 Feedyard 12 Fertilizer storage 16 Other (specify below)

13 Insecticide storage

Direction from well? How many feet?

FROM TO LITHOLOGIC LOG FROM TO PLUGGING INTERVALS

0 12' Silty Sand12 32' SANDCONTRACTOR'S OR LANDOWNER'S CERTIFICATION: This water well was (1) constructed, (2) reconstructed, or (3) plugged under my jurisdiction and was completed on (mo/day/year) 1-11-01 and this record is true to the best of my knowledge and belief. KansasWater Well Contractor's License No. 604 This Water Well Record was completed on (mo/day/yr) 3-9-01Under the business name of Environmental Priority Service, Inc by (signature) Dary Ray

INSTRUCTIONS: Use typewriter or ball point pen. PLEASE PRESS FIRMLY and PRINT clearly. Please fill in blanks, underline or circle the correct answers. Send two copies to Kansas Department of Health and Environment, Bureau of Water, Topeka, Kansas 66620-0001. Telephone: 913-296-5545. Send one to WATER WELL OWNER and retain one for your records.