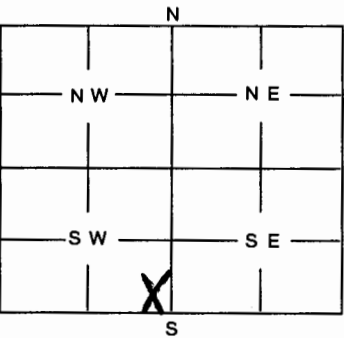


1 LOCATION OF WATER WELL: County: <u>Sedgwick</u>	Fraction <u>SE 1/4 SW 1/4</u>	Section Number <u>9</u>	Township Number <u>27S</u>	Range Number <u>1E</u>
--	-------------------------------	-------------------------	----------------------------	------------------------

Distance and direction from nearest town or city street address of well if located within city? see below

2 WATER WELL OWNER: <u>Cargill Inc.</u> RR #, St. Address, Box #: <u>715 E. 13th</u> City, State, ZIP Code: <u>Wichita, KS 67214</u>	Board of Agriculture, Division of Water Resources Application Number: _____
--	--

3 MARK WELL'S LOCATION WITH AN "X" IN SECTION BOX:  <div style="text-align: center;">  </div>	4 DEPTH OF WELL <u>600</u> ft. WELL'S STATIC WATER LEVEL <u>20</u> ft.  WELL WAS USED AS: <table style="width:100%;"> <tr> <td>1 Domestic</td> <td>5 Public Water Supply</td> <td>9 Dewatering</td> </tr> <tr> <td>2 Irrigation</td> <td>6 Oil Field Water Supply</td> <td>10 Monitoring Well</td> </tr> <tr> <td>3 Feedlot</td> <td>7 Domestic (Lawn &amp; Garden)</td> <td>11 Injection Well</td> </tr> <tr> <td>4 Industrial</td> <td>8 Air Conditioning</td> <td>12 Other _____</td> </tr> </table> <p>Was a chemical / bacteriological sample submitted to Department? Yes _____ No <u>X</u> _____          If yes, mo/day/yr sample was submitted _____          Water Well Disinfected: Yes <u>X</u> No _____</p>	1 Domestic	5 Public Water Supply	9 Dewatering	2 Irrigation	6 Oil Field Water Supply	10 Monitoring Well	3 Feedlot	7 Domestic (Lawn & Garden)	11 Injection Well	4 Industrial	8 Air 

5 TYPE OF BLANK CASING USED:

1 Steel	3 RMP (SR)	5 Wrought	7 Fiberglass	9 Other (Specify below)
2 PVC	4 ABS	6 Asbestos-Cement	8 Concrete Tile	

Blank casing diameter 6 in. Was casing pulled? Yes \_\_\_\_\_ No X \_\_\_\_\_ If yes, how much \_\_\_\_\_  
 Casing height above or below land surface \_\_\_\_\_ in.

6 GROUT PLUG MATERIAL: 1 Neat cement 2 Cement grout 3 Bentonite 4 Other \_\_\_\_\_

GROUT PLUG INTERVALS: From 20 ft. to 600 ft., From \_\_\_\_\_ ft. to \_\_\_\_\_ ft., From \_\_\_\_\_ ft. to \_\_\_\_\_ ft.

What is the nearest source of possible contamination:

1 Septic tank	6 Seepage pit	11 Fuel storage	16 Other (specify below)
2 Sewer lines	7 Pit privy	12 Fertilizer storage	
3 Watertight sewer lines	8 Sewage lagoon	13 Insecticide storage	
4 Lateral lines	9 Feedyard	14 Abandoned water well	
5 Cess Pool	10 Livestock pens	15 Oil well/Gas well	

Direction from well? WEST How many feet? 60

FROM	TO	PLUGGING MATERIALS
<del>60</del>	<del>20</del>	
<u>60</u>	<u>20</u>	<u>gravel</u>
<u>20</u>	<u>0</u>	<u>Cement</u>

7 CONTRACTOR'S OR LANDOWNER'S CERTIFICATION: This water well was plugged under my jurisdiction and was completed on (mo/day/year) 5-30-01 and this record is true to the best of my knowledge and belief. Kansas Water Well Contractor's License No. 318 This Water Well Record was completed on (mo/day/year) \_\_\_\_\_

by (signature) Michael George Weninger Drilling Inc.

INSTRUCTIONS: Use typewriter or ball point pen. Please press firmly and print clearly. Please fill in blanks, underline or circle the correct answers. Send top three copies to Kansas Department of Health and Environment, Bureau of Water, Topeka, Kansas 66620-0001. Telephone: 785/296-3565. Send one to Water Well Owner and retain one for your records.