

LOCATION OF WATER WELL:	Fraction	NE NW SE SE	Section Number	Township Number	Range Number
County: Sedgewick	4/16 1/4	SW 1/4	16 8	T 27 S	R 1 E/W


Distance and direction from nearest town or city street address of well if located within city?
SW corner of 15th and Park Place, Wichita, KS 67214

WATER WELL OWNER: City of Wichita
RR#, St. Address, Box #: 1900 E 9th STREET
City, State, ZIP Code: Wichita KS 67214 NMW-135

Board of Agriculture, Division of Water Resources
Application Number:

LOCATE WELL'S LOCATION WITH AN "X" IN SECTION BOX: 4 DEPTH OF COMPLETED WELL: 20.7 ft. ELEVATION: _____

Depth(s) Groundwater Encountered 1. 1.4 ft. 2. _____ ft. 3. _____ ft.

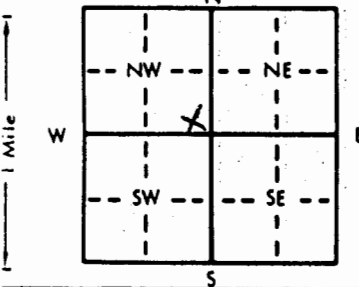

WELL'S STATIC WATER LEVEL . . . 11.4 . . . ft. below land surface measured on mo/day/yr

Pump test data: Well water was ft. after hours pumping gpm

Est: Yield gpm; Well water was ft. after hours pumping gpm

Bore Hole Diameter. 3/4" . . . in. to 20.6 . . . ft., and in. to ft.

WELL WATER TO BE USED AS:

5 Public water supply	8 Air conditioning	11 Injection well		
1 Domestic	3 Feedlot	6 Oil field water supply	9 Dewatering	12 Other (Specify below)
2 Irrigation	4 Industrial	7 Lawn and garden only	10 Monitoring well	

Was a chemical/bacteriological sample submitted to Department? Yes.....No.....X.....; If yes, mo/day/yr sample was submitted

Water Well Disinfected? Yes No X

TYPE OF BLANK CASING USED:		5 Wrought iron	8 Concrete tile	CASING JOINTS: Glued Clamped
1 Steel	3 RMP (SR)	6 Asbestos-Cement	9 Other (specify below)	Welded
② PVC	4 ABS	7 Fiberglass		Threaded <input checked="" type="checkbox"/>

Blank casing diameter 3 1/4 in. to 10 1/4 ft. Dia. in. to ft. Dia. in. to ft.
Casing height above land surface 0 in. weight lbs./ft. Wall thickness or gauge No. SC 80

TYPE OF SCREEN OR PERFORATION MATERIAL:			CPVC	10 Asbestos-cement
1 Steel	3 Stainless steel	5 Fiberglass	8 RMP (SR)	11 Other (specify)
2 Brass	4 Galvanized steel	6 Concrete tile	9 ABS	12 None used (open hole)

SCREEN OR PERFORATION OPENINGS ARE:		5 Gauzed wrapped	8 Saw cut	11 None (open hole)
1 Continuous slot	3 Mill slot	6 Wire wrapped	9 Drilled holes	
2 Louvered shutter	4 Key punched	7 Torch cut	10 Other (specify)	

SCREEN-PERFORATED INTERVALS: From 10.4 ft. to 20.2 ft., From ft. to ft.
From ft. to ft., From ft. to ft.
GRAVEL PACK INTERVALS: From 8.6 ft. to 20.6 ft., From ft. to ft.
From ft. to ft., From ft. to ft.

GROUT MATERIAL: 1 Neat cement 2 Cement grout 3 Bentonite 4 Other

Grout Intervals: From . . . 0.5 . . . ft. to . . . 5 . . . ft. From ft. to ft. From ft. to ft.

What is the nearest source of possible contamination:

1 Septic tank	4 Lateral lines	7 Pit privy	10 Livestock pens	14 Abandoned water well
2 Sewer lines	5 Cess pool	8 Sewage lagoon	11 Fuel storage	15 Oil well/Gas well
3 Watertight sewer lines	6 Seepage pit	9 Feedyard	12 Fertilizer storage	16 Other (specify below)
Direction from well?			13 Insecticide storage	

FROM			TO			LITHOLOGIC LOG			FROM			TO			PLUGGING INTERVALS		

		A/E			
O N	14 20.	Silly Clay Sand			
			RECEIVED	RECEIVED	
			OCT 10 2001	AUG 24 2001	
			BUREAU OF WATER	BUREAU OF WATER	

CONTRACTOR'S OR LANDOWNER'S CERTIFICATION: This water well was (1) constructed, (2) reconstructed, or (3) plugged under my jurisdiction and was completed on (mo/day/year) 8-6-01 and this record is true to the best of my knowledge and belief. Kansas Water Well Contractor's License No. 604 This Water Well Record was completed on (mo/day/yr) 8-20-01 under the business name of Environmental Priority Service Inc by (signature) [Signature]