

LOCATION OF WATER WELL:		Fraction	Section Number	Township Number	Range Number
County: Sedowick		1/4 NE 1/4 SW 1/4	4	T 27 S	R 10 W


LOCATION OF WATER WELL:		Fraction	Section Number	Township Number	Range Number
County: Sedowick		1/4 NE 1/4 SW 1/4	4	T 27 S	R 10 W

Distance and direction from nearest town or city street address of well if located within city?

2549 n. NEW YORK AVE. Wichita, Ks

WATER WELL OWNER: SAFETY-KLEEN	
RR#. St. Address, Box #: 2549 N. NEW YORK AVE.	Board of Agriculture, Division of Water Resources
City, State, ZIP Code: WICHITA, KS 67219	Application Number:

LOCATE WELL'S LOCATION WITH AN "X" IN SECTION BOX: 4 DEPTH OF COMPLETED WELL: 25' ft. ELEVATION: 17' # 1 # 2 # 3 # 4

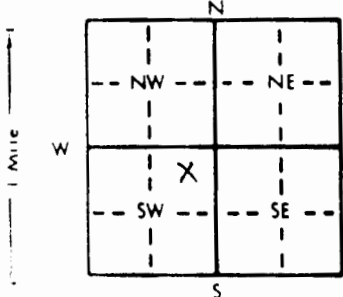






WELL WATER TO BE USED AS:

5 Public water supply	8 Air conditioning	11 Injection well		
1 Domestic	3 Feedlot	6 Oil field water supply	9 Dewatering	12 Other (Specify below)
2 Irrigation	4 Industrial	7 Lawn and garden only	10 Monitoring well	

Was a chemical/bacteriological sample submitted to Department? Yes.....No.....☒.....; If yes, mo/day/yr sample was submitted

Water Well Disinfected? Yes.....No.....☒

TYPE OF BLANK CASING USED:		5 Wrought iron	8 Concrete tile	CASING JOINTS: Glued	Clamped
1 Steel	3 RMP (SR)	6 Asbestos-Cement	9 Other (specify below)	Welded	
2 PVC	4 ABS	7 Fiberglass		Threaded	X
Blank casing diameter $\frac{3}{4}$ in. to 15 ft. Dia		in. to ft. Dia		in. to ft.	
Casing height above land surface - 2 in.		weight lbs./ft.		Wall thickness or gauge No. 56 80	

TYPE OF SCREEN OR PERFORATION MATERIAL:			⑦ PVC	10 Asbestos-cement
1 Steel	3 Stainless steel	5 Fiberglass	8 RMP (SR)	11 Other (specify)
2 Brass	4 Galvanized steel	6 Concrete tile	9 ABS	12 None used (open hole)

SCREEN OR PERFORATION OPENINGS ARE:		5 Gauzed wrapped	8 Saw cut	11 None (open hole)
1 Continuous slot	③ Mill slot	6 Wire wrapped	9 Drilled holes	
2 Louvered shutter	4 Key punched	7 Torch cut	10 Other (specify) _____	
SCREEN-PERFORATED INTERVALS:	From 15	ft. to 25	ft. From	ft. to
	From	ft. to	ft. From	ft. to
GRAVEL PACK INTERVALS:	From 1.3	ft. to 25'	ft. From	ft. to
	From	ft. to	ft. From	ft. to

GROUT MATERIAL: 1 Neat cement 2 Cement grout ☒ Bentonite 4 Other _____
 Grout Intervals: From 0 ft. to 13 ft., From _____ ft. to _____ ft., From _____ ft. to _____ ft.
 What is the nearest source of possible contamination:
 1 Septic tank 4 Lateral lines 7 Pit privy 10 Livestock pens 14 Abandoned water we
 2 Sewer lines 5 Cess pool 8 Sewage lagoon 11 Fuel storage 15 Oil well/Gas well
 3 Watertight sewer lines 6 Seepage pit 9 Feedyard 12 Fertilizer storage 16 Other (specify below)
 13 Insecticide storage **TANK Pit**

Direction from well? _____ How many feet? _____

[illegible]

CONTRACTOR'S OR LANDOWNER'S CERTIFICATION: This water well was (1) constructed, (2) reconstructed, or (3) plugged under my jurisdiction and was completed on (mo/day/year) 11-12-01 and this record is true to the best of my knowledge and belief. Water Well Contractor's License No. 604 This Water Well Record was completed on (mo/day/yr) 11-13-01 under the business name of Environmental Priority Service, Inc. by signature [Signature]

INSTRUCTIONS: Use typewriter or ball point pen. PLEASE PRESS FIRMLY and PRINT clearly. Please fill in blanks, underline or circle the correct answers. Send top three copies to Kansas Department of Health and Environment, Bureau of Water, Topeka, Kansas 66620-0001. Telephone: 913-298-5545. Send one to WATER WELL OWNER and retain one for your records.