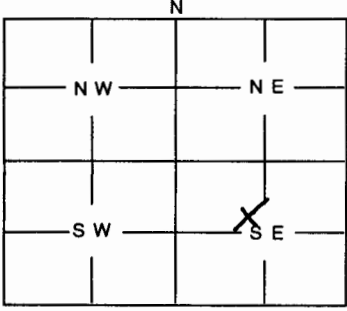


1	LOCATION OF WATER WELL:	Fraction	Section Number	Township Number	Range Number
	County: JEDGWICK	SE 1/4 NW 1/4 SE 1/4	26	T 27 S	R 1 E

Distance and direction from nearest town or city street address of well if located within city?

NW corner of driveway - vacant lot 4301 Bayley

2	WATER WELL OWNER:	Board of Agriculture, Division of Water Resources
	RR #, St. Address, Box #:	Application Number:
	City, State, ZIP Code :	Unknown

3	MARK WELL'S LOCATION WITH AN "X" IN SECTION BOX:	4	DEPTH OF WELL 51 ft												
			WELL'S STATIC WATER LEVEL 17 ft.												
			WELL WAS USED AS:												
			<table border="0"> <tr> <td>1 Domestic</td> <td>5 Public Water Supply</td> <td>9 Dewatering</td> </tr> <tr> <td>2 Irrigation</td> <td>6 Oil Field Water Supply</td> <td>10 Monitoring Well</td> </tr> <tr> <td>3 Feedlot</td> <td>7 Domestic (Lawn & Garden)</td> <td>11 Injection Well</td> </tr> <tr> <td>4 Industrial</td> <td>8 Air Conditioning</td> <td>12 Other Unknown</td> </tr>
			Was a chemical / bacteriological sample submitted to Department? Yes No X												
			If yes, mo/day/yr sample was submitted												
			Water Well Disinfected: Yes X No												

5	TYPE OF BLANK CASING USED:
	<input checked="" type="radio"/> Steel 3 RMP (SR) 5 Wrought 7 Fiberglass 9 Other (Specify below) 2 PVC 4 ABS 6 Asbestos-Cement 8 Concrete Tile
	Blank casing diameter 8 in. Was casing pulled? Yes X No
	Casing height above or below land surface 3.6 in. If yes, how much 2-5 ft

6	GROUT PLUG MATERIAL:	1 Neat cement	2 Cement grout	3 Bentonite	4 Other
	Grout Plug Intervals:	From 6 ft. to 3 ft.,	From ft. to ft.,	From ft. to ft.	
	What is the nearest source of possible contamination:				
	1 Septic tank 6 Seepage pit 11 Fuel storage 16 Other (specify below) 2 Sewer lines 7 Pit privy 12 Fertilizer storage well was abandoned 3 Watertight sewer lines 8 Sewage lagoon 13 Insecticide storage 4 Lateral lines 9 Feedyard 14 Abandoned water well 5 Cess Pool 10 Livestock pens 15 Oil well/Gas well				
	Direction from well? How many feet?				

FROM	TO	PLUGGING MATERIALS
3	0	Topsoil
6	3	Bentonite
18	6	Subsoil
52	8	Sand/bleach

7	CONTRACTOR'S OR LANDOWNER'S CERTIFICATION: This water well was plugged under my jurisdiction and was completed on (mo/day/year) 2/16/03 and this record is true to the best of my knowledge and belief. Kansas Water Well Contractor's License No. 628 This Water Well Record was completed on (mo/day/year) 2/17/03 under the business name of Immenturices by (signature) James H. Hays
---	--

INSTRUCTIONS: Use typewriter or ball point pen. Please press firmly and print clearly. Please fill in blanks, underline or circle the correct answers. Send top three copies to Kansas Department of Health and Environment, Bureau of Water, Topeka, Kansas 66620-0001. Telephone: 785/296-3565. Send one to Water Well Owner and retain one for your records.