

WATER WELL PLUGGING RECORD

Form WWC-5P

KSA 82a-1212

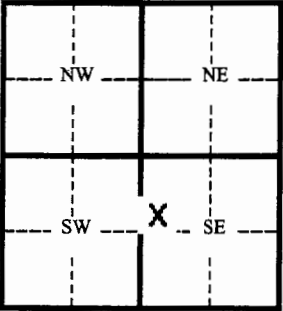
ID No.

1 LOCATION OF WATER WELL:	Fraction	Section Number	Township Number	Range Number
County: Sedgwick	SW 1/4 NW 1/4 SE 1/4	28	27	01 E

Distance and direction from nearest town or city street address of well if located within city?

37' E & 4' S of NE corner of 1327 Ida

2 WATER WELL OWNER:	Kenneth Stewart	Board of Agriculture, Division of Water Resources
RR#, St. Address, Box #	3901 N. Harding	Application Number:
City, State, ZIP Code :	Wichita, KS 67220	

3 MARK WELL'S LOCATION WITH AN "X" IN SECTION BOX:	4 DEPTH OF WELL 20 ft.												
	WELL'S STATIC WATER LEVEL 15.21 ft. WELL WAS USED AS: <table border="0"> <tr> <td>1 Domestic</td> <td>5 Public Water Supply</td> <td>9 Dewatering</td> </tr> <tr> <td>2 Irrigation</td> <td>6 Oil Field Water Supply</td> <td>10 Monitoring Well</td> </tr> <tr> <td>3 Feedlot</td> <td>7 Lawn and Garden (domestic)</td> <td>11 Injection Well</td> </tr> <tr> <td>4 Industrial</td> <td>8 Air Conditioning</td> <td>12 Other</td> </tr>
	Was a chemical/bacteriological sample submitted to Department? Yes _____ No X If yes, mo/day/yr sample was submitted _____ Water Well Disinfected: Yes _____ No X												

5 TYPE OF BLANK CASING USED:	1 Steel	3 RMP (SR)	5 Wrought	7 Fiberglass	9 Other (specify below)
	2 PVC	4 ABC	6 Asbestos-Cement	8 Concrete Tile	
Blank casing diameter 2 in.	Was casing pulled? Yes X No _____	If yes, how much 20			
Casing height above or below land surface 0 in.	Overdrill 20 feet				

6 GROUT PLUG MATERIAL:	1 Neat cement	2 Cement grout	3 Bentonite	4 Other
Grout Plug Intervals From 2 ft. to 20 ft. From _____ ft. to _____ ft. From _____ ft. to _____ ft.				

What is the nearest source of possible contamination:

- | | | | |
|--------------------------|-------------------|-------------------------|--------------------------|
| 1 Septic tank | 6 Seepage pit | 11 Fuel storage | 16 Other (specify below) |
| 2 Sewer lines | 7 Pit privy | 12 Fertilizer storage | |
| 3 Watertight sewer lines | 8 Sewage lagoon | 13 Insecticide storage | |
| 4 Lateral lines | 9 Feedyard | 14 Abandoned water well | |
| 5 Cess Pool | 10 Livestock pens | 15 Oil well/ Gas well | |

Direction from well? _____ How many feet? _____

FROM	TO	CODE	PLUGGING MATERIALS
0	2		Soil
2	20		Bentonite

7 CONTRACTOR'S OR LANDOWNER'S CERTIFICATION: This water well was plugged under my jurisdiction and was completed on (mo/day/yr) 3-12-03 and this record is true to the best of my knowledge and belief. Kansas Water Well Contractor's License No. 531 This Water Well Record was completed on (mo/day/yr) 4-9-03 under the business name of Geotechnical Services, Inc. by (signature) <i>Allen M. Smith</i>

INSTRUCTIONS: Please fill in blanks and circle the correct answers. Send three copies to Kansas Department of Health and Environment, Bureau of Water, 1000 S W Jackson St., Ste. 420, Topeka, Kansas 66620-0001. Telephone: 785-296-3565. Send one to Water Well Owner and retain one for your records.