

1	LOCATION OF WATER WELL:	Fraction	Section Number	Township Number	Range Number
County:	<u>SEDGWICK</u>	<u>NE 1/4 SE 1/4 NW 1/4</u>	<u>9</u>	<u>27</u>	<u>1E</u>

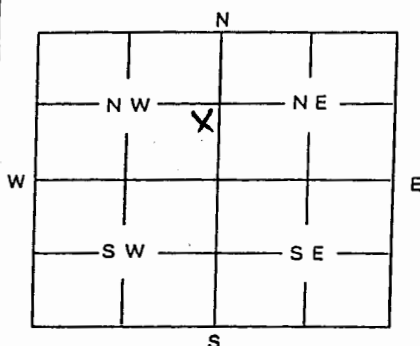
Distance and direction from nearest town or city street address of well if located within city?

270' E AND 30' S OF CENTERLINE OF MASLEY AND 19<sup>th</sup> STREETS, WICHITA, KS.2 WATER WELL OWNER: SECURITY OILRR #, St. Address, Box #: P.O. BOX 48220City, State, ZIP Code : WICHITA, KANSAS 67201

Board of Agriculture, Division of Water Resources

Application Number:

3 MARK WELL'S LOCATION WITH AN "X" IN SECTION BOX:

4 DEPTH OF WELL 35 ftWELL'S STATIC WATER LEVEL NA ft.

WELL WAS USED AS:

- 1 Domestic
- 2 Irrigation
- 3 Feedlot
- 4 Industrial

- 5 Public Water Supply
- 6 Oil Field Water Supply
- 7 Domestic (Lawn & Garden)
- 8 Air Conditioning

- 9 Dewatering
- 10 Monitoring Well
- 11 Injection Well
- 12 Other RECOVERY WELL

Was a chemical / bacteriological sample submitted to Department? Yes ..... No ☒

If yes, mo/day/yr sample was submitted .....

Water Well Disinfected: Yes ..... No ☒

5 TYPE OF BLANK CASING USED:

- 1 Steel
- 2 PVC
- 3 RMP (SR)
- 4 ABS
- 5 Wrought
- 6 Asbestos-Cement
- 7 Fiberglass
- 8 Concrete Tile
- 9 Other (Specify below)

Blank casing diameter 6 in. Was casing pulled? Yes ..... No ☒ If yes, how much .....Casing height above or below land surface 0 in.6 GROUT PLUG MATERIAL: 1 Neat cement 2 Cement grout 3 Bentonite 4 Other SAND/NATIVE SOIL  
Grout Plug Intervals: From 5 ft. to 25 ft., From 25 ft. to 35 ft., From 0 to 5 ft.

What is the nearest source of possible contamination:

- 1 Septic tank
- 2 Sewer lines
- 3 Watertight sewer lines
- 4 Lateral lines
- 5 Cess Pool
- 6 Seepage pit
- 7 Pit privy
- 8 Sewage lagoon
- 9 Feedyard
- 10 Livestock pens
- 11 Fuel storage
- 12 Fertilizer storage
- 13 Insecticide storage
- 14 Abandoned water well
- 15 Oil well/Gas well

16 Other (specify below) UNKNOWN

Direction from well? ..... How many feet? .....

FROM	TO	PLUGGING MATERIALS
0'	5'	NATIVE SOIL
5'	25'	BENTONITE
25'	35'	SAND

RW 3

7 CONTRACTOR'S OR LANDOWNER'S CERTIFICATION: This water well was plugged under my jurisdiction and was completed on (mo/day/year) 5/2/03 and this record is true to the best of my knowledge and belief. Kansas Water Well Contractor's License No. 527 This Water Well Record was completed on (mo/day/year) 5/30/03 under the business name of GEOCORE INC. by (signature) Doc Bell

INSTRUCTIONS: Use typewriter or ball point pen. Please press firmly and print clearly. Please fill in blanks, underline or circle the correct answers. Send top three copies to Kansas Department of Health and Environment, Bureau of Water, Topeka, Kansas 66620-0001. Telephone: 785/296-3565. Send one to Water Well Owner and retain one for your records.