


WATER WELL RECORD Form WWC-5 KSA 82a-1212

1 LOCATION OF WATER WELL: Sedgwick FRACTION NE SE SE NW 1/4 SECTION NUMBER 21 TOWNSHIP NUMBER T 27 S RANGE NUMBER R 1E E/W

Distance and direction from nearest town or city street address of well if located within city? 128 & 132 N. Mosley Wichita, Kansas

2 WATER WELL OWNER: 132 N. Mosley LLC RR# ST. ADDRESS, BOX #: 132 N. Mosley CITY, STATE: Wichita, Kansas ZIP CODE: Application Number:

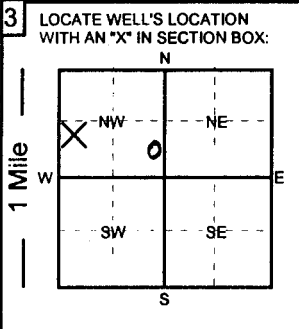

3 LOCATE WELL'S LOCATION WITH AN "X" IN SECTION BOX: 4 DEPTH OF WELL: 21 ft. ELEVATION: basement floor Depth of groundwater Encountered: 13 FT. BELOW LAND SURFACE MEASURED ON 6/30/03

5 TYPE OF CASING USED: 1. Steel 2. PVC 3. RPM (SR) 4. ABS 5. Wrought Iron 6. Asbestos-Cement 7. Fiberglass 8. Concrete tile 9. Other (Specify below) CASING JOINTS: Glued Threaded Welded Clamped

6 GROUT MATERIALS: 1. Neat cement 2. Cement Grout 3. Bentonite Other bentonite hole plug Grout intervals: From 0 ft. to 21 ft.

LITHOLOGIC LOG table with columns 'From' and 'To' and rows for log entries. Includes 'bentonite hole plug' entry from 0 to 21 ft.

7 Contractor's or Landowner's Certification: This water well was 1. constructed 2. reconstructed or 3. plugged under my jurisdiction and was completed on (mo/day/year) 6-30-2003

Kansas Water Well Contractor's License No. 236 This water well record was completed on (mo/day/year) 7-2-2003 under the business name of Harp Well & Pump Service Inc. by (signature) J o d d S. Harp