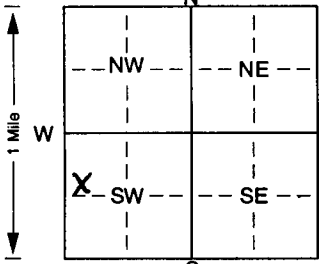


1 LOCATION OF WATER WELL:		Fraction	Section Number	Township Number	Range Number
County: <u>Sedgwick</u>		<u>SW 1/4 NW 1/4 SW 1/4</u>	<u>33</u>	T <u>27</u> S	R <u>1</u> <u>EN</u>
Distance and direction from nearest town or city street address of well if located within city? <u>2160 S Broadway Wichita, KS</u>					
2 WATER WELL OWNER:		<u>John Ve</u> RR#, St. Address, Box # : <u>2160 S Broadway</u> City, State, ZIP Code : <u>Wichita, KS</u>			
3 LOCATE WELL'S LOCATION WITH AN "X" IN SECTION BOX:		4 DEPTH OF COMPLETED WELL: <u>23</u> ft. ELEVATION: ft. Depth(s) Groundwater Encountered 1. <u>18</u> ft. 2. ft. 3. ft. WELL'S STATIC WATER LEVEL: <u>17.45</u> ft. below land surface measured on mo/day/yr <u>4/10/03</u> Pump test data: Well water was ft. after hours pumping gpm Est. Yield gpm: Well water was ft. after hours pumping gpm Bore Hole Diameter: <u>3.5</u> in. to <u>23</u> ft., and in. to ft. WELL WATER TO BE USED AS: 5 Public water supply 8 Air conditioning 11 Injection well 1 Domestic 3 Feedlot 6 Oil field water supply 9 Dewatering 12 Other (Specify below) 2 Irrigation 4 Industrial 7 Domestic (lawn & garden) 10 Monitoring well Was a chemical/bacteriological sample submitted to Department? Yes. No. <u>X</u> ; If yes, mo/day/yr sample was submitted Water Well Disinfected? Yes No <u>X</u>			
					
5 TYPE OF BLANK CASING USED:		CASING JOINTS: Glued. Clamped.			
1 Steel 3 RMP (SR) 6 Asbestos-Cement 9 Other (specify below) Welded 2 PVC 4 ABS 7 Fiberglass Threaded. <u>X</u>					
Blank casing diameter in. to <u>13</u> ft., Dia. in. to ft., Dia. in. to ft.		Casing height above land surface in., weight lbs./ft. Wall thickness or gauge No. <u>SCH 40</u>			
TYPE OF SCREEN OR PERFORATION MATERIAL:		7 PVC 10 Asbestos-cement 1 Steel 3 Stainless steel 5 Fiberglass 8 RMP (SR) 11 Other (specify) 2 Brass 4 Galvanized steel 6 Concrete tile 9 ABS 12 None used (open hole)			
SCREEN OR PERFORATION OPENINGS ARE:		5 Gauzed wrapped 8 Saw cut 11 None (open hole) 1 Continuous slot 3 Mill slot 6 Wire wrapped 9 Drilled holes 2 Louvered shutter 4 Key punched 7 Torch cut 10 Other (specify) ft.			
SCREEN-PERFORATED INTERVALS: From. <u>13</u> ft. to <u>23</u> ft., From. ft. to ft.					
GRAVEL PACK INTERVALS: From. <u>10</u> ft. to <u>23</u> ft., From. ft. to ft.					
6 GROUT MATERIAL:		1 Neat cement 2 Cement grout 3 Bentonite 4 Other Grout Intervals: From. <u>2</u> ft. to <u>10</u> ft., From. ft. to ft., From. ft. to ft.			
What is the nearest source of possible contamination:		10 Livestock pens 14 Abandoned water well 1 Septic tank 4 Lateral lines 7 Pit privy 11 Fuel storage 15 Oil well/Gas well 2 Sewer lines 5 Cess pool 8 Sewage lagoon 12 Fertilizer storage 16 Other (specify below) 3 Watertight sewer lines 6 Seepage pit 9 Feedyard 13 Insecticide storage Direction from well? <u>East</u> How many feet? <u>250</u>			
FROM	TO	LITHOLOGIC LOG	FROM	TO	PLUGGING INTERVALS
<u>0</u>	<u>6</u>	<u>Silty Clay</u>			
<u>6</u>	<u>9</u>	<u>Silty Clay w/ sand lenses</u>			
<u>9</u>	<u>11</u>	<u>Sandy Silt</u>			
<u>11</u>	<u>16</u>	<u>Sand, medium grained, poorly graded</u>			
<u>16</u>	<u>23</u>	<u>Sand, coarse grain, well graded</u>			
7 CONTRACTOR'S OR LANDOWNER'S CERTIFICATION: This water well was (1) constructed, (2) reconstructed, or (3) plugged under my jurisdiction and was completed on (mo/day/year) <u>3/10/03</u> and this record is true to the best of my knowledge and belief. Kansas Water Well Contractor's Licence No. <u>710</u> This Water Well Record was completed on (mo/day/yr) <u>3/27/03</u> under the business name of <u>Below Ground Surface, Inc.</u> by (signature) <u>whit</u>					
INSTRUCTIONS: Use typewriter or ball point pen. PLEASE PRESS FIRMLY and PRINT clearly. Please fill in blanks, underline or circle the correct answers. Send top three copies to Kansas Department of Health and Environment, Bureau of Water, Topeka, Kansas 66620-0001. Telephone 785-296-5524. Send one to WATER WELL OWNER and retain one for your records. Fee of \$5.00 for each constructed well.					