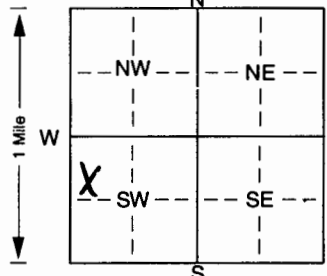


1 LOCATION OF WATER WELL:		Fraction	Section Number	Township Number	Range Number
County: <u>Sedgwick</u>		<u>SW 1/4 NW 1/4 SW 1/4</u>	<u>33</u>	T <u>27</u> S	R <u>1</u> <u>EW</u>
Distance and direction from nearest town or city street address of well if located within city? <u>2160 S. Broadway Wichita, KS</u>					
2 WATER WELL OWNER:		<u>John Ye</u> RR#, St. Address, Box # : <u>2160 S Broadway</u> City, State, ZIP Code : <u>Wichita, KS</u>			
		Board of Agriculture, Division of Water Resources Application Number: <u>mw-14</u>			
3 LOCATE WELL'S LOCATION WITH:		4 DEPTH OF COMPLETED WELL: <u>23</u> ft. ELEVATION:			
AN "X" IN SECTION BOX: 		Depth(s) Groundwater Encountered <u>1.18</u> ft. 2. <u>18</u> ft. 3. <u>410/03</u> ft. WELL'S STATIC WATER LEVEL <u>17.18</u> ft. below land surface measured on mo/day/yr Pump test data: Well water was <u>—</u> ft. after <u>—</u> hours pumping <u>—</u> gpm Est. Yield <u>—</u> gpm: Well water was <u>—</u> ft. after <u>—</u> hours pumping <u>—</u> gpm Bore Hole Diameter <u>3.5</u> in. to <u>23</u> ft. and <u>—</u> in. to <u>—</u> ft. WELL WATER TO BE USED AS: 1 Domestic 3 Feedlot 6 Oil field water supply 9 Dewatering 12 Other (Specify below) 2 Irrigation 4 Industrial 7 Domestic (lawn & garden) 10 Monitoring well			
		Was a chemical/bacteriological sample submitted to Department? Yes. <u>—</u> No. <u>X</u> ; If yes, mo/day/yr sample was sub- mitted Water Well Disinfected? Yes <u>—</u> No <u>X</u>			
5 TYPE OF BLANK CASING USED:		CASING JOINTS: Glued. <u>—</u> Clamped. <u>—</u>			
1 Steel 3 RMP (SR) 5 Wrought iron 8 Concrete tile 2 VC 4 ABS 6 Asbestos-Cement 9 Other (specify below)		Welded <u>—</u> Threaded <u>X</u>			
Blank casing diameter <u>1</u> in. to <u>13</u> ft. Dia <u>—</u> in. to <u>—</u> ft. Dia <u>—</u> in. to <u>—</u> ft.					
Casing height above land surface <u>—</u> in., weight <u>—</u> lbs./ft. Wall thickness or gauge No. <u>SCH 40</u>					
TYPE OF SCREEN OR PERFORATION MATERIAL:		7 PVC 10 Asbestos-cement 8 RMP (SR) 11 Other (specify) <u>—</u> 9 ABS 12 None used (open hole)			
SCREEN OR PERFORATION OPENINGS ARE:		5 Gauzed wrapped 8 Saw cut 11 None (open hole) 1 Continuous slot 3 Mill slot 9 Drilled holes 2 Louvered shutter 4 Key punched 10 Other (specify) <u>—</u> ft.			
SCREEN-PERFORATED INTERVALS: From <u>13</u> ft. to <u>23</u> ft. From <u>—</u> ft. to <u>—</u> ft.					
GRAVEL PACK INTERVALS: From <u>10</u> ft. to <u>23</u> ft. From <u>—</u> ft. to <u>—</u> ft.					
6 GROUT MATERIAL:		1 Neat cement 2 Cement grout 3 Bentonite 4 Other <u>—</u> Grout Intervals: From <u>2</u> ft. to <u>10</u> ft. From <u>—</u> ft. to <u>—</u> ft. From <u>—</u> ft. to <u>—</u> ft.			
What is the nearest source of possible contamination:		10 Livestock pens 14 Abandoned water well 1 Septic tank 4 Lateral lines 7 Pit privy 11 Fuel storage 15 Oil well/Gas well 2 Sewer lines 5 Cess pool 8 Sewage lagoon 12 Fertilizer storage 16 Other (specify below) 3 Watertight sewer lines 6 Seepage pit 9 Feedyard 13 Insecticide storage			
Direction from well? <u>South</u>		How many feet? <u>50</u>			
FROM	TO	LITHOLOGIC LOG	FROM	TO	PLUGGING INTERVALS
<u>0</u>	<u>6</u>	<u>Silty Clay</u>			
<u>6</u>	<u>7</u>	<u>Sand, fine</u>			
<u>7</u>	<u>8</u>	<u>Silty Clay</u>			
<u>8</u>	<u>10</u>	<u>Silty Sand</u>			
<u>10</u>	<u>19</u>	<u>Sand, fine, poorly graded</u>			
<u>19</u>	<u>21</u>	<u>Sand, coarse, well graded</u>			
<u>21</u>	<u>23</u>	<u>Sand, med graded, well graded</u>			
7 CONTRACTOR'S OR LANDOWNER'S CERTIFICATION: This water well was (1) constructed, (2) reconstructed, or (3) plugged under my jurisdiction and was completed on (mo/day/year) <u>3/10/03</u> and this record is true to the best of my knowledge and belief. Kansas Water Well Contractor's Licence No. <u>710</u> This Water Well Record was completed on (mo/day/yr) <u>3/27/03</u> under the business name of <u>Belowground Surface, Inc.</u> by (signature) <u>calhoun</u>					