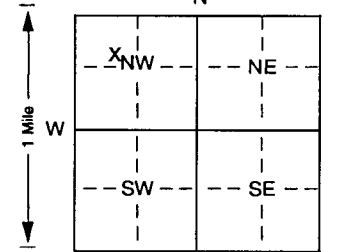


1 LOCATION OF WATER WELL:		Fraction		Section Number		Township Number		Range Number	
County: Sedgwick		SE 1/4 NW 1/4 NW 1/4		30		T 27 S		R 1 E W	
Distance and direction from nearest town or city street address of well if located within city?									
West of the intersection of Bonn St. and University St.									
2 WATER WELL OWNER: Friends University									
RR#, St. Address, Box # : 2100 W. University St. Board of Agriculture, Division of Water Resources									
City, State, ZIP Code : Wichita, KS 67213-3397 Application Number: 45,504									
3 LOCATE WELL'S LOCATION WITH AN "X" IN SECTION BOX:		4 DEPTH OF COMPLETED WELL 44.46 ft. ELEVATION: unknown							
		Depth(s) Groundwater Encountered 1 ft. 2 ft. 3 ft.							
		WELL'S STATIC WATER LEVEL 13 ft. below land surface measured on mo/day/yr 10-10-03							
		Pump test data: Well water was not checked ft. after hours pumping gpm							
		Est. Yield unknown gpm: Well water was ft. after hours pumping gpm							
		Bore Hole Diameter 30 in. to 44 ft., and in. to ft.							
		WELL WATER TO BE USED AS: 5 Public water supply 8 Air conditioning 11 Injection well							
		1 Domestic 3 Feedlot 6 Oil field water supply 9 Dewatering 12 Other (specify below)							
		2 Irrigation 4 Industrial 7 Domestic (lawn & garden) 10 Monitoring well Thermal Exchange							
		Was a chemical/bacteriological sample submitted to Department? Yes No If yes, mo/day/yr sample was submitted							
		Water Well Disinfected? Yes No							
5 TYPE OF BLANK CASING USED:									
1 Steel 3 RMP (SR) 5 Wrought iron 8 Concrete tile CASING JOINTS: Glued Clamped									
2 PVC 4 ABS 6 Asbestos-Cement 9 Other (specify below) Welded									
7 Fiberglass Threaded									
Blank casing diameter 12 3/4 in. to 28.67 ft., Dia in. to ft., Dia in. to ft.									
Casing height above land surface 17 in., weight 49.56 lbs./ft. Wall thickness or gauge No .375									
TYPE OF SCREEN OR PERFORATION MATERIAL:									
1 Steel 3 Stainless steel 5 Fiberglass 8 RMP (SR) 10 Asbestos-cement									
2 Brass 4 Galvanized steel 6 Concrete tile 9 ABS 11 Other (specify)									
12 None used (open hole)									
SCREEN OR PERFORATION OPENINGS ARE:									
1 Continuous slot 3 Mill slot 5 Gauzed wrapped 8 Saw cut 11 None (open hole)									
2 Louvered shutter 4 Key punched 6 Wire wrapped 9 Drilled holes									
7 Torch cut 10 Other (specify) ft.									
SCREEN-PERFORATED INTERVALS: From 28.67 ft. to 43 ft., From ft. to ft.									
From ft. to ft., From ft. to ft.									
GRAVEL PACK INTERVALS: From 22 ft. to 44 ft., From ft. to ft.									
From ft. to ft., From ft. to ft.									
6 GROUT MATERIAL: 1 Neat cement 2 Cement grout 3 Bentonite 4 Other Bentonite Holeplug									
Compacted Soil									
Grout Intervals: From 0 ft. to 5 ft., From 5 ft. to 13 ft., From 13 ft. to 22 ft.									
What is the nearest source of possible contamination:									
1 Septic tank 4 Lateral lines 7 Pit privy 10 Livestock pens 14 Abandoned water well									
2 Sewer lines 5 Cess pool 8 Sewage lagoon 11 Fuel storage 15 Oil well/Gas well									
3 Watertight sewer lines 6 Seepage pit 9 Feedyard 12 Fertilizer storage 16 Other (specify below)									
13 Insecticide storage None known									
Direction from well? How many feet?									
FROM TO LITHOLOGIC LOG FROM TO PLUGGING INTERVALS									
0 1 Topsoil									
1 9 Clay									
9 19 Sand and gravel, fine, medium									
19 20 Clay, black									
20 23 Sand and gravel, fine, medium, coarse									
23 40 Sand and gravel, fine, medium									
40 43 Sand and gravel, fine, medium, coarse									
43 44 Shale, gray									
7 CONTRACTOR'S OR LANDOWNER'S CERTIFICATION: This water well was (1) constructed (2) reconstructed or (3) plugged under my jurisdiction and was completed on (mo/day/year) 10-10-03 and this record is true to the best of my knowledge and belief. Kansas Water Well Contractor's License No 185 This Water Well Record was completed on (mo/day/yr) 10-15-02 by (signature) Clarke Well & Equipment, Inc.									
INSTRUCTIONS: Use typewriter or ball point pen. PLEASE PRESS FIRMLY and PRINT clearly. Please fill in blanks, underline or circle the correct answers. Send top three copies to Kansas Department of Health and Environment, Bureau of Water, Topeka, Kansas 66620-0001. Telephone 785-296-5524. Send one to WATER WELL OWNER and retain one for your records. Fee of \$5.00 for each constructed well.									