


1	LOCATION OF WATER WELL: Sedgwick	FRACTION SW 1/4 SE 1/4 SW 1/4	SECTION NUMBER 7	TOWNSHIP NUMBER T 27 S	RANGE NUMBER R 1E E/W
---	--	---	----------------------------	----------------------------------	---------------------------------

Northwest corner of 13th & Clarence **Wichita, Kansas**

RR#,ST. ADDRESS,BOX #: **455 N. Main**
CITY, STATE: **Wichita, Kansas**

ZIP CODE: _____ Application Number: _____

ELEVATION:

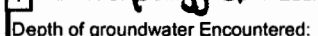

Depth of groundwater Encountered: ft. ft. ft.

WELL'S STATIC WATER LEVEL 12 FT. BELOW LAND SURFACE MEASURED ON mo/day/yr: 7/14/04

Pump test date:	Well water was	ft. after	hours of pumping @	gpm.
-----------------	----------------	-----------	--------------------	------

Est. Yield:	Pump test data:	Well water was	ft. after	hours of pumping @	gpm

Est. Yield:	gpm	Well water was	ft. after	hours of pumping @	gpm
-------------	-----	----------------	-----------	--------------------	-----

Bore Hole Diameter	in.	to	ft.	and	in.	to	ft.
--------------------	-----	----	-----	-----	-----	----	-----

WELL WATER TO BE USED AS:

1. Domestic 3. Feedlot 5. Public water supply 7. Lawn and garden only 9. Dewatering 12. Other (Specify below)

2. Irrigation 4. Industrial 6. Oil field water supply 8. Air conditioning 10. Monitoring well

Was a chemical/bacteriological sample submitted to Department? YES ☐ NO ☒ : If yes, what mo/day/yr was sample

Was Water Well Disinfected? ☒ YES ☐ NO

1. Steel	3. RPM (SR)	5. Wrought Iron	7. Fiberglass	9. Other (Specify below)	CASING JOINTS:	Class	Threaded
						Welded	Clamped

2. PVC 4. ABS 6. Asbestos-Cement 8. Concrete tile

Blank casing diameter 8 in. to ft., Dia. in. to ft., Dia. in. to ft.

Casing height below land surface:	36	in.	Weight:	lbs. / ft.	Wall thickness or gauge No.	
-----------------------------------	----	-----	---------	------------	-----------------------------	--

TYPE OF SCREEN OR PERFORATION MATERIAL:

1. Steel 3. Stainless Steel 5. Fiberglass 7. PVC 9. ABS 11. Other (specify) N/A

1. Steel	3. Stainless Steel	5. Fiberglass	7. PVC	9. Polypropylene	11. Other (specify):
2. Brass	4. Galvanized	6. Concrete Tile	8. RMP (SP)	10. Asbestos Cement	12. None used (open hole)

SCREEN OR PERFORATION OPENINGS ARE:

1. Continuous slot 3. Mill slot 5. Gauzed wrapped 7. Torch cut 9. Drilled holes 11. None (open hole)

1	2	
1	2	

SCREEN - PERFORATION INTERVAL	From	ft	to	ft	From	"	to	"
-------------------------------	------	----	----	----	------	---	----	---

From	To	From	To
1	2	1	2

From _____ ft. to _____ ft., From _____ ft. to _____ ft.

GRAVEL PACK INTERVALS: From ft. to ft., From ft. # to ft.


6	GROUT MATERIALS:	1. Neat cement	2. Cement Grout	3. Bentonite	Other	bentonite hole plug
---	------------------	----------------	-----------------	--------------	-------	---------------------

Grout Intervals: From ft. to ft., From ft. to ft. From 3 ft. to 24 ft.

What is the nearest source of possible contamination:

1. Septic tank 4. Lateral lines 7. Pit privy 10. Livestock pens 13. Insecticide storage 15. Oil well/Gas well

3. Sewer lines 5. Gas Pool 8. Sewage lagoon 11. Fuel storage 14. Abandon water well 16. Other (specify below)

2. Sewer lines	3. Cess Pool	3. Sewage lagoon	10. Solid storage	14. Abandon water well	None Apparent
----------------	--------------	------------------	-------------------	------------------------	---------------

3. Watertight sewer line	6. Seepage pit	9. Feed yard	12. Fertilizer storage	None Apparent
--------------------------	----------------	--------------	------------------------	---------------

Direction from well?

How many feet?

[illegible]

7 Contractor's or Landowner's Certification: This water well was 1. **constructed** 2. **reconstructed** or 3. **plugged** under my jurisdiction and was completed on (mo/day/year) **7/14/2004** and this record is true to the best of my knowledge and belief.

Kansas Water Well Contractor's License No. **236** This water well record was completed on (mo/day/year) **7/16/2004**

under the business name of **Harp Well & Pump Service Inc.**

by (signature)

To d d S. H r p