

NWL-115

## WATER WELL RECORD Form WWC-5 KSA 82a-1212

|                                                      |                                         |                            |                                  |                              |
|------------------------------------------------------|-----------------------------------------|----------------------------|----------------------------------|------------------------------|
| 1 LOCATION OF WATER WELL:<br>County: <u>Sedgwick</u> | Fraction<br><u>NW 1/4 SW 1/4 NE 1/4</u> | Section Number<br><u>4</u> | Township Number<br><u>T 27 S</u> | Range Number<br><u>R 1 E</u> |
|------------------------------------------------------|-----------------------------------------|----------------------------|----------------------------------|------------------------------|

Distance and direction from nearest town or city street address of well if located within city?

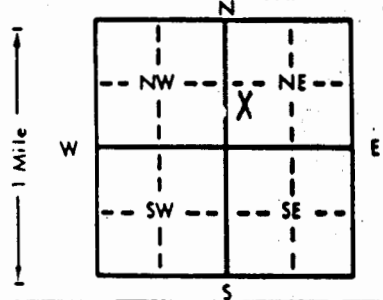
380' N of N edge of 26th St, 2' W of W edge of Meade

2 WATER WELL OWNER: City of Wichita  
 RR#, St. Address, Box #: Wichita, KS 67206  
 City, State, ZIP Code: Wichita, KS 67206

Board of Agriculture, Division of Water Resources

Application Number:

3 LOCATE WELL'S LOCATION WITH AN "X" IN SECTION BOX:



WELL WATER TO BE USED AS: 5 Public water supply 8 Air conditioning 11 Injection well

1 Domestic 3 Feedlot 6 Oil field water supply 9 Dewatering 12 Other (Specify below)

2 Irrigation 4 Industrial 7 Lawn and garden only 10 Monitoring well

Was a chemical/bacteriological sample submitted to Department? Yes X No X; If yes, mo/day/yr sample was submittedWater Well Disinfected? Yes X No X

5 TYPE OF BLANK CASING USED:


TYPE OF SCREEN OR PERFORATION MATERIAL:

1 Steel 3 Stainless steel 5 Fiberglass 8 RMP (SR) 10 Asbestos-cement

2 Brass 4 Galvanized steel 6 Concrete tile 9 ABS 11 Other (specify)

SCREEN OR PERFORATION OPENINGS ARE: 5 Gauzed wrapped 8 Saw cut 11 None (open hole)

1 Continuous slot 3 Mill slot 6 Wire wrapped 9 Drilled holes

2 Louvered shutter 4 Key punched 7 Torch cut 10 Other (specify)



7 CONTRACTOR'S OR LANDOWNER'S CERTIFICATION: This water well was (1) constructed, (2) reconstructed, or (3) plugged under my jurisdiction and was completed on (mo/day/year) June 14, 2004 and this record is true to the best of my knowledge and belief. Kansas Water Well Contractor's License No. 604 This Water Well Record was completed on (mo/day/yr) Aug 13, 2004 under the business name of Environmental Priority Inc by (signature) [Signature]

INSTRUCTIONS: Use typewriter or ball point pen. PLEASE PRESS FIRMLY and PRINT clearly. Please fill in blanks, underline or circle the correct answers. Send top three copies to Kansas Department of Health and Environment, Bureau of Water, Topeka, Kansas 66620-0001. Telephone: 913-296-5545. Send one to WATER WELL OWNER and retain one for your records.

RECEIVED

AUG 18 2004

BUREAU OF WATER