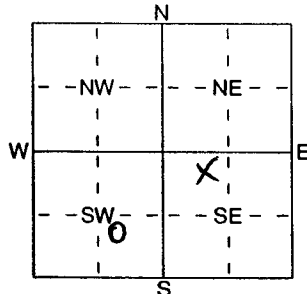


1 LOCATION OF WATER WELL:	Fraction <u>NW SE SW</u>	Section Number <u>9</u>	Township Number <u>T 27 S</u>	Range Number <u>R 1</u> <u>(EW)</u>
County: <u>Sedgwick</u>	<u>NE 1/4 NW 1/4 SE 1/4</u>			

Distance and direction from nearest town or city street address of well if located within city?

1520 N. Barwise, Wichita, KSMA-22 WATER WELL OWNER: Brunntag Southwest, IncRR#, St. Address, Box # : 1520 N. BarwiseCity, State, ZIP Code : Wichita, KS 67201Board of Agriculture, Division of Water Resource
Application Number:3 LOCATE WELL'S LOCATION WITH 4 DEPTH OF COMPLETED WELL 20 ft. ELEVATION:

AN "X" IN SECTION BOX:

Depth(s) Groundwater Encountered 1 ft. NA ft. 2 ft. 3 ft.WELL'S STATIC WATER LEVEL NA ft. below land surface measured on mo/day/yr

Pump test data: Well water was ft. after hours pumping gpi

Est. Yield gpm: Well water was ft. after hours pumping gpi

WELL WATER TO BE USED AS: 5 Public water supply 8 Air conditioning 11 Injection well

1 Domestic 3 Feedlot 6 Oil field water supply 9 Dewatering 12 Other (Specify below)

2 Irrigation 4 Industrial 7 Domestic (lawn & garden) 10 Monitoring well PiezometerWas a chemical/bacteriological sample submitted to Department? Yes No X; If yes, mo/day/yr sample was submitted
Water Well Disinfected? Yes No X

5 TYPE OF BLANK CASING USED: 5 Wrought iron 8 Concrete tile CASING JOINTS: Glued Clamped

1 Steel 3 RMP (SR) 6 Asbestos-Cement 9 Other (specify below) Welded

OPVC 4 ABS 7 Fiberglass Threaded XBlank casing diameter 1 in. to 10 ft. Dia in. to ft. Dia in. to ft.Casing height above land surface 0 in. weight lbs./ft. Wall thickness or gauge No. SC-80

TYPE OF SCREEN OR PERFORATION MATERIAL:

1 Steel 3 Stainless Steel 5 Fiberglass 8 RMP (SR) 10 Asbestos-Cement

2 Brass 4 Galvanized Steel 6 Concrete tile 9 ABS 11 Other (Specify)

12 None used (open hole)

SCREEN OR PERFORATION OPENINGS ARE:

Continuous slot 3 Mill slot 5 Guazed wrapped 8 Saw cut 11 None (open hole)

2 Louvered shutter 4 Key punched 6 Wire wrapped 9 Drilled holes

7 Torch cut 10 Other (specify)

SCREEN-PERFORATED INTERVALS: From 10 ft. to 20 ft. From ft. to ft.

From ft. to ft. From ft. to ft.

GRAVEL PACK INTERVALS: From 8 ft. to 20 ft. From ft. to ft.

From ft. to ft. From ft. to ft.

6 GROUT MATERIAL: 1 Neat cement 2 Cement grout Bentonite 4 OtherGrout intervals: From 1 ft. to 8 ft. From ft. to ft. From ft. to ft.

What is the nearest source of possible contamination:

1 Septic tank 4 Lateral lines 7 Pit privy 10 Livestock pens 14 Abandoned water well

2 Sewer lines 5 Cess pool 8 Sewage lagoon 11 Fuel storage 15 Oil well/Gas well

3 Watertight sewer lines 6 Seepage pit 9 Feedyard 12 Fertilizer storage 16 Other (specify below)

Direction from well? How many feet?

FROM TO LITHOLOGIC LOG FROM TO PLUGGING INTERVALS

0 6 Clay6 20 Sand

RECEIVED

AUG 23 2004

BUREAU OF WATER

7 CONTRACTOR'S OR LANDOWNER'S CERTIFICATION: This water well was (1) constructed, (2) reconstructed, or (3) plugged under my jurisdiction and was completed on (mo/day/year) 8-10-04 and this record is true to the best of my knowledge and belief. Kansas Water Well Contractor's Licence No 705 This Water Well Record was completed on (mo/day/yr) 8-13-04 under the business name of Handex by (signature) [Signature]