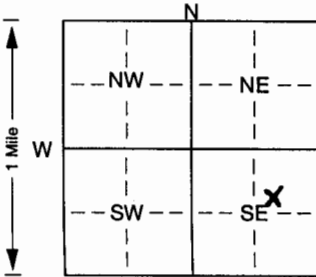


1] LOCATION OF WATER WELL:		Fraction	Section Number	Township Number	Range Number
County: SEDGWICK		SW 1/4 NE 1/4 SE 1/4	27	T 27 S	R 1 E
Distance and direction from nearest town or city street address of well if located within city? backyard - 2921 Menlo Wichita KS					
2] WATER WELL OWNER: Earl Levine/Victoria Page					
RR#, St. Address, Box # : 2921 Menlo			Board of Agriculture, Division of Water Resources		
City, State, ZIP Code : Wichita KS 67211			Application Number: Unknown		
3] LOCATE WELL'S LOCATION WITH		4] DEPTH OF COMPLETED WELL: 32 ft. ELEVATION:			
AN "X" IN SECTION BOX:		Depth(s) Groundwater Encountered 1. 17 ft. 2. ft. 3. ft.			
		WELL'S STATIC WATER LEVEL 17 ft. below land surface measured on mo/day/yr 9/28/04			
		Pump test data: Well water was ft. after hours pumping gpm			
		Est. Yield gpm: Well water was ft. after hours pumping gpm			
		Bore Hole Diameter. in. to ft., and in. to ft.			
		WELL WATER TO BE USED AS: 5 Public water supply 8 Air conditioning 11 Injection well			
		1 Domestic 3 Feedlot 6 Oil field water supply 9 Dewatering 12 Other (Specify below)			
		2 Irrigation 4 Industrial Domestic (lawn & garden) 10 Monitoring well			
		Was a chemical/bacteriological sample submitted to Department? Yes. No. X ; If yes, mo/day/yr sample was submitted Water Well Disinfected? Yes No X			
5] TYPE OF BLANK CASING USED:					
1 Steel		3 RMP (SR)		5 Wrought iron	
2 PVC		4 ABS		6 Asbestos-Cement	
				7 Fiberglass	
Blank casing diameter 5 1/2 in. to ft., Dia				8 Concrete tile	
Casing height 14 in., weight lbs./ft. Wall thickness or gauge No.				9 Other (specify below)	
TYPE OF SCREEN OR PERFORATION MATERIAL: Unknown		7 PVC		10 Asbestos-cement	
1 Steel		3 Stainless steel		5 Fiberglass	
2 Brass		4 Galvanized steel		6 Concrete tile	
SCREEN OR PERFORATION OPENINGS ARE: Unknown		7 Torch cut		8 Saw cut	
1 Continuous slot		3 Mill slot		9 Drilled holes	
2 Louvered shutter		4 Key punched		10 Other (specify) ft.	
SCREEN-PERFORATED INTERVALS: From ft. to ft., From ft. to ft., From ft. to ft., From ft. to ft.		5 Gauzed wrapped		11 None (open hole)	
GRAVEL PACK INTERVALS: From ft. to ft., From ft. to ft., From ft. to ft., From ft. to ft.		6 Wire wrapped			
		7 Torch cut			
6] GROUT MATERIAL: 1 Neat cement 2 Cement grout 3 Bentonite 4 Other					
Grout Intervals: From 13 ft. to 2 ft., From ft. to ft., From ft. to ft., From ft. to ft.					
What is the nearest source of possible contamination:					
1 Septic tank		4 Lateral lines		7 Pit privy	
2 Sewer lines		5 Cess pool		8 Sewage lagoon	
3 Watertight sewer lines		6 Seepage pit		9 Feedyard	
Direction from well?				10 Livestock pens	
				11 Fuel storage	
				12 Fertilizer storage	
				13 Insecticide storage	
				14 Abandoned water well	
				15 Oil well/Gas well	
				16 Other (specify below)	
				How many feet?	
FROM	TO	LITHOLOGIC LOG	FROM	TO	PLUGGING INTERVALS
		Extend casing - 14 inches above ground			
		Install pitless adaptor			
		Sanitary well seal			
		grout casing			
		Electrical			
		Plumb to sprinkler system			
		Safety Rope			
7] CONTRACTOR'S OR LANDOWNER'S CERTIFICATION: This water well was (1) constructed (2) reconstructed or (3) plugged under my jurisdiction and was completed on (mo/day/year) 9/28/04 and this record is true to the best of my knowledge and belief. Kansas Water Well Contractor's Licence No. 628 This Water Well Record was completed on (mo/day/yr) 9/27/04 under the business name of JM Enterprises by (signature) James M. [Signature]					
INSTRUCTIONS: Use typewriter or ball point pen. PLEASE PRESS FIRMLY and PRINT clearly. Please fill in blanks, underline or circle the correct answers. Send top three copies to Kansas Department of Health and Environment, Bureau of Water, Topeka, Kansas 66620-0001. Telephone 785-296-5524. Send one to WATER WELL OWNER and retain one for your records. Fee of \$5.00 for each constructed well.					