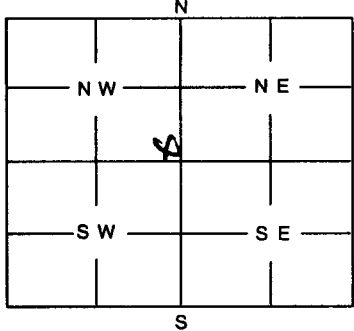


1	LOCATION OF WATER WELL: County: <u>Sedgwick</u>	Fraction <u>SE 1/4 SE 1/4 NW 1/4</u>	Section <u>21</u>	Township <u>27S</u>	Range <u>1E</u>																								
Distance and direction from nearest town or city street address of well if located within city? <u>923 E. 1st St., Wichita</u>																													
2 WATER WELL OWNER: <u>Southwest Paper Company, Inc.</u> RR #, St. Address, Box #: <u>PO Box 21270</u> City, State, ZIP Code: <u>Wichita, KS 67208</u> Board of Agriculture, Division of Water Resources Application Number:																													
3 MARK WELL'S LOCATION WITH AN "X" IN SECTION BOX: <div style="text-align: center;">  </div>		4 DEPTH OF WELL ..... <u>27.00</u> ..... ft WELL'S STATIC WATER LEVEL ..... <u>13.41</u> ..... ft WELL WAS USED AS: <table style="width:100%;"> <tr> <td>1 Domestic</td> <td>5 Public Water Supply</td> <td>9 Dewatering</td> </tr> <tr> <td>2 Irrigation</td> <td>6 Oil Field Water Supply</td> <td><u>10</u> Monitoring Well</td> </tr> <tr> <td>3 Feedlot</td> <td>7 Domestic (Lawn &amp; Garden)</td> <td>11 Injection Well</td> </tr> <tr> <td>4 Industrial</td> <td>8 Air Conditioning</td> <td>12 Other .....</td> </tr> </table> Was a chemical / bacteriological sample submitted to Department? Yes ..... No <u>X</u> If yes, mo/day/yr sample was submitted ..... <u>NA</u> Water Well Disinfected: Yes ..... No <u>X</u>				1 Domestic	5 Public Water Supply	9 Dewatering	2 Irrigation	6 Oil Field Water Supply	<u>10</u> Monitoring Well	3 Feedlot	7 Domestic (Lawn & Garden)	11 Injection Well	4 Industrial	8 Air Conditioning	12 Other .....												
1 Domestic	5 Public Water Supply	9 Dewatering																											
2 Irrigation	6 Oil Field Water Supply	<u>10</u> Monitoring Well																											
3 Feedlot	7 Domestic (Lawn & Garden)	11 Injection Well																											
4 Industrial	8 Air Conditioning	12 Other .....																											
5 TYPE OF BLANK CASING USED: <table style="width:100%;"> <tr> <td>1 Steel</td> <td>3 RMP (SR)</td> <td>5 Wrought</td> <td>7 Fiberglass</td> <td>9 Other (Specify below)</td> </tr> <tr> <td><u>2</u> PVC</td> <td>4 ABS</td> <td>6 Asbestos-Cement</td> <td>8 Concrete Tile</td> <td></td> </tr> </table> Blank casing diameter ..... <u>5</u> ..... in. Was casing pulled? Yes <u>X</u> No ..... If yes, how much ..... <u>27.00</u> Casing height above or below land surface ..... in.						1 Steel	3 RMP (SR)	5 Wrought	7 Fiberglass	9 Other (Specify below)	<u>2</u> PVC	4 ABS	6 Asbestos-Cement	8 Concrete Tile															
1 Steel	3 RMP (SR)	5 Wrought	7 Fiberglass	9 Other (Specify below)																									
<u>2</u> PVC	4 ABS	6 Asbestos-Cement	8 Concrete Tile																										
6 GROUT PLUG MATERIAL: 1 Neat cement 2 Cement grout <u>3</u> Bentonite 4 Other ..... Grout Plug Intervals: From <u>27</u> ft. to <u>2</u> ft., From ..... ft. to ..... ft., From ..... to ..... ft. What is the nearest source of possible contamination: <table style="width:100%;"> <tr> <td>1 Septic tank</td> <td>6 Seepage pit</td> <td><u>11</u> Fuel storage</td> <td>16 Other (specify below)</td> </tr> <tr> <td>2 Sewer lines</td> <td>7 Pit privy</td> <td>12 Fertilizer storage</td> <td></td> </tr> <tr> <td>3 Watertight sewer lines</td> <td>8 Sewage lagoon</td> <td>13 Insecticide storage</td> <td></td> </tr> <tr> <td>4 Lateral lines</td> <td>9 Feedyard</td> <td>14 Abandoned water well</td> <td></td> </tr> <tr> <td>5 Cess Pool</td> <td>10 Livestock pens</td> <td>15 Oil well/Gas well</td> <td></td> </tr> </table> Direction from well? ..... <u>E</u> ..... How many feet? ..... <u>120</u> .....						1 Septic tank	6 Seepage pit	<u>11</u> Fuel storage	16 Other (specify below)	2 Sewer lines	7 Pit privy	12 Fertilizer storage		3 Watertight sewer lines	8 Sewage lagoon	13 Insecticide storage		4 Lateral lines	9 Feedyard	14 Abandoned water well		5 Cess Pool	10 Livestock pens	15 Oil well/Gas well					
1 Septic tank	6 Seepage pit	<u>11</u> Fuel storage	16 Other (specify below)																										
2 Sewer lines	7 Pit privy	12 Fertilizer storage																											
3 Watertight sewer lines	8 Sewage lagoon	13 Insecticide storage																											
4 Lateral lines	9 Feedyard	14 Abandoned water well																											
5 Cess Pool	10 Livestock pens	15 Oil well/Gas well																											
<table border="1" style="width:100%; border-collapse: collapse;"> <thead> <tr> <th style="width:10%;">FROM</th> <th style="width:10%;">TO</th> <th style="width:80%;">PLUGGING MATERIALS</th> </tr> </thead> <tbody> <tr> <td><u>0</u></td> <td><u>2</u></td> <td><u>Mottex Mtl + Pavement</u></td> </tr> <tr> <td><u>2</u></td> <td><u>27</u></td> <td><u>Chophentontite - hydrated</u></td> </tr> <tr><td> </td><td> </td><td> </td></tr> <tr><td> </td><td> </td><td> </td></tr> <tr><td> </td><td> </td><td> </td></tr> <tr><td> </td><td> </td><td> </td></tr> <tr><td> </td><td> </td><td> </td></tr> </tbody> </table>						FROM	TO	PLUGGING MATERIALS	<u>0</u>	<u>2</u>	<u>Mottex Mtl + Pavement</u>	<u>2</u>	<u>27</u>	<u>Chophentontite - hydrated</u>															
FROM	TO	PLUGGING MATERIALS																											
<u>0</u>	<u>2</u>	<u>Mottex Mtl + Pavement</u>																											
<u>2</u>	<u>27</u>	<u>Chophentontite - hydrated</u>																											
7 CONTRACTOR'S OR LANDOWNER'S CERTIFICATION: This water well was plugged under my jurisdiction and was completed on (mo/day/year) ..... <u>10/26/04</u> ..... and this record is true to the best of my knowledge and belief. Kansas Water Well Contractor's License No. .... <u>650</u> ..... This Water Well Record was completed on (mo/day/year) ..... <u>11/3/04</u> ..... under the business name of <u>Deffenbaugh Field Services</u> by (signature) <u>[Signature]</u>																													

RECEIVED

NOV 17 2004

BUREAU OF WATER