

1	LOCATION OF WATER WELL:	Fraction <u>SE SW SE SE</u>	Section Number <u>7</u>	Township Number <u>T 27 S</u>	Range Number <u>R 1 E</u>
County: <u>SEOGWICK</u> <u>SW 1/4 SW 1/4 SE 1/4</u> <u>7</u> <u>T 27 S</u> <u>R 1 E</u> E/W					

Distance and direction from nearest town or city street address of well if located within city?

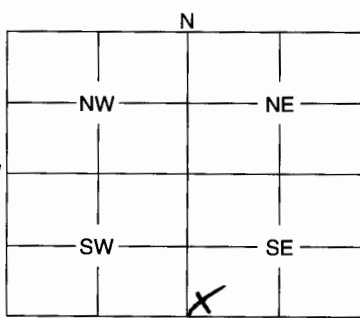
northwest corner northeast basement (furnace) 1414 Linnett Wichita

2	WATER WELL OWNER:	<u>Winfred Brundige Trust</u> <u>Entrust Bank</u>	<u>KS 67203</u>
---	-------------------	--	-----------------

RR #, St. Address, Box #:
City, State, ZIP Code :Wichita KS 67201

Board of Agriculture, Division of Water Resources

Application Number: Unknown

3	MARK WELL'S LOCATION WITH AN "X" IN SECTION BOX:	4	DEPTH OF WELL <u>30</u> ft. WELL'S STATIC WATER LEVEL <u>15</u> ft. WELL WAS USED AS: <table border="0"> <tr> <td>1 Domestic</td> <td>5 Public Water Supply</td> <td>9 Dewatering</td> </tr> <tr> <td>2 Irrigation</td> <td>6 Oil Field Water Supply</td> <td>10 Monitoring Well</td> </tr> <tr> <td>3 Feedlot</td> <td>7 Domestic (Lawn & Garden)</td> <td>11 Injection Well</td> </tr> <tr> <td>4 Industrial</td> <td>8 Air Conditioning</td> <td>12 Other</td> </tr> </table>	1 Domestic	5 Public Water Supply	9 Dewatering	2 Irrigation	6 Oil Field Water Supply	10 Monitoring Well	3 Feedlot	7 Domestic (Lawn & Garden)	11 Injection Well	4 Industrial	8 Air Conditioning	12 Other
1 Domestic	5 Public Water Supply	9 Dewatering													
2 Irrigation	6 Oil Field Water Supply	10 Monitoring Well													
3 Feedlot	7 Domestic (Lawn & Garden)	11 Injection Well													
4 Industrial	8 Air Conditioning	12 Other													
		Was a chemical / bacteriological sample submitted to Department? Yes No <u>X</u> If yes, mo/day/yr sample was submitted Water Well Disinfected: Yes <u>X</u> No													

5	TYPE OF BLANK CASING USED:
<input checked="" type="checkbox"/> Steel 3 RMP (SR) 5 Wrought 7 Fiberglass 9 Other (Specify below) <input type="checkbox"/> PVC 4 ABS 6 Asbestos-Cement 8 Concrete Tile	
Blank casing diameter <u>1 1/4</u> in. Was casing pulled? Yes <u>X</u> No If yes, how much <u>3 ft</u> Casing height above or below land surface <u>36</u> in.	

6	GROUT PLUG MATERIAL:	1 Neat cement	<input checked="" type="checkbox"/> Cement grout	<input checked="" type="checkbox"/> Bentonite	4 Other															
Grout Plug Intervals: From <u>30</u> ft. to <u>5</u> ft., From ft. to ft., From to ft.																				
What is the nearest source of possible contamination:																				
<table border="0"> <tr> <td>1 Septic tank</td> <td>6 Seepage pit</td> <td>11 Fuel storage</td> </tr> <tr> <td>2 Sewer lines</td> <td>7 Pit privy</td> <td>12 Fertilizer storage</td> </tr> <tr> <td>3 Watertight sewer lines</td> <td>8 Sewage lagoon</td> <td>13 Insecticide storage</td> </tr> <tr> <td>4 Lateral lines</td> <td>9 Feedyard</td> <td>14 Abandoned water well</td> </tr> <tr> <td>5 Cess pool</td> <td>10 Livestock pens</td> <td>15 Oil well/Gas well</td> </tr> </table>						1 Septic tank	6 Seepage pit	11 Fuel storage	2 Sewer lines	7 Pit privy	12 Fertilizer storage	3 Watertight sewer lines	8 Sewage lagoon	13 Insecticide storage	4 Lateral lines	9 Feedyard	14 Abandoned water well	5 Cess pool	10 Livestock pens	15 Oil well/Gas well
1 Septic tank	6 Seepage pit	11 Fuel storage																		
2 Sewer lines	7 Pit privy	12 Fertilizer storage																		
3 Watertight sewer lines	8 Sewage lagoon	13 Insecticide storage																		
4 Lateral lines	9 Feedyard	14 Abandoned water well																		
5 Cess pool	10 Livestock pens	15 Oil well/Gas well																		
Direction from well? How many feet?																				

FROM	TO	PLUGGING MATERIALS
<u>45</u>	<u>0</u>	<u>Cement</u>
<u>30</u>	<u>5</u>	<u>Bentonite / bleach</u>

7	CONTRACTOR'S OR LANDOWNER'S CERTIFICATION: This water well was plugged under my jurisdiction and was completed on (mo/day/year) <u>1/01/05</u> and this record is true to the best of my knowledge and belief. Kansas Water Well Contractor's License No. <u>622</u> This Water Well Record was completed on (mo/day/year) <u>1/01/05</u> under the business name of <u>Wichita Twp. S.E.</u> by (signature) <u>[Signature]</u>
---	--

INSTRUCTIONS: Use typewriter or ball point pen. Please press firmly and print clearly. Please fill in blanks, underline or circle the correct answers. Send top three copies to Kansas Department of Health and Environment, Bureau of Water, Geology Section, 1000 SW Jackson St., Ste. 420, Topeka, Kansas 66612-1367. Telephone: 785/296-5522. Send one to Water Well Owner and retain one for your records.