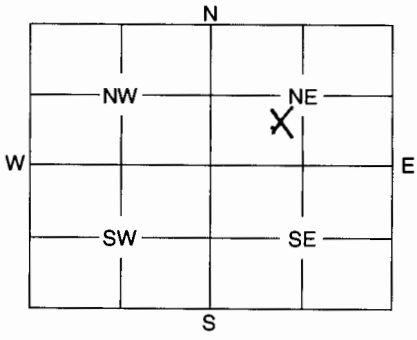


1	LOCATION OF WATER WELL:	Fraction NW SE NE NE ¼ ¼ ¼	Section Number 7 MARK ROAD	Township Number 27 South	Range Number 1 East E/W
County: Sedgwick					

Distance and direction from nearest town or city street address of well if located within city?

2040 Litchfield

2	WATER WELL OWNER: Jeff Crosby	Board of Agriculture, Division of Water Resources Application Number:
RR #, St. Address, Box #: 2040 Litchfield		
City, State, ZIP Code: Wichita, KS 67203		

3	MARK WELL'S LOCATION WITH AN "X" IN SECTION BOX:	4	DEPTH OF WELL 23 ft. WELL'S STATIC WATER LEVEL 8 ft. WELL WAS USED AS: <input checked="" type="checkbox"/> 1 Domestic <input checked="" type="checkbox"/> 2 Irrigation <input type="checkbox"/> 3 Feedlot <input type="checkbox"/> 4 Industrial <input type="checkbox"/> 5 Public Water Supply <input type="checkbox"/> 6 Oil Field Water Supply <input type="checkbox"/> 7 Domestic (Lawn & Garden) <input type="checkbox"/> 8 Air Conditioning <input type="checkbox"/> 9 Dewatering <input type="checkbox"/> 10 Monitoring Well <input type="checkbox"/> 11 Injection Well <input checked="" type="checkbox"/> 12 Other
		Was a chemical / bacteriological sample submitted to Department? Yes No <input checked="" type="checkbox"/> If yes, mo/day/yr sample was submitted Water Well Disinfected: Yes <input checked="" type="checkbox"/> No	

5	TYPE OF BLANK CASING USED:
1 Steel 3 RMP (SR) 5 Wrought 7 Fiberglass 9 Other (Specify below) Sandpoint, utility room 2 PVC 4 ABS 6 Asbestos-Cement 8 Concrete Tile	
Blank casing diameter in. Was casing pulled? Yes No If yes, how much Casing height above or below land surface in.	

6	GROUT PLUG MATERIAL:	1 Neat cement	<input checked="" type="checkbox"/> 2 Cement grout	3 Bentonite	4 Other
Grout Plug Intervals: From 23 ft. to 0 ft., From ft. to ft., From to ft.					
What is the nearest source of possible contamination:					
1 <input checked="" type="checkbox"/> Septic tank 6 Seepage pit 11 Fuel storage 16 Other (specify below) 2 <input checked="" type="checkbox"/> Sewer lines 7 Pit privy 12 Fertilizer storage 3 Watertight sewer lines 8 Sewage lagoon 13 Insecticide storage 4 Lateral lines 9 Feedyard 14 Abandoned water well 5 Cess pool 10 Livestock pens 15 Oil well/Gas well					
Direction from well? west How many feet? 5 ft					

FROM	TO	PLUGGING MATERIALS
23	0	Cement

7	CONTRACTOR'S OF LANDOWNER'S CERTIFICATION: This water well was plugged under my jurisdiction and was completed on (mo/day/year) 2-17-05 and this record is true to the best of my knowledge and belief. Kansas Water Well Contractor's License No. This Water Well Record was completed on (mo/day/year)
by (signature) Jeff Crosby under the business name of 2-17-05	

INSTRUCTIONS: Use typewriter or ball point pen. Please press firmly and print clearly. Please fill in blanks, underline or circle the correct answers. Send top three copies to Kansas Department of Health and Environment, Bureau of Water, Geology Section, 1000 SW Jackson St., Ste. 420, Topeka, Kansas 66612-1367. Telephone: 785/296-5522. Send one to Water Well Owner and retain one for your records.