

1	LOCATION OF WATER WELL:	Fraction	Section Number	Township Number	Range Number
County:	Sedgwick	NW ¼ SE ¼ SW ¼	33	T 27 S	R 1 E/W


Distance and direction from nearest town or city street address of well if located within city?

2 WATER WELL OWNER: Cintas Corporation
RR#, St. Address, Box # : 2213 South mead Street
City, State, ZIP Code : Wichita, KS 67211

Board of Agriculture, Division of Water Resources
Application Number:

3	LOCATE WELL'S LOCATION WITH	4	DEPTH OF COMPLETED WELL 35 ft. ELEVATION:
---	-----------------------------	---	---

AN "X" IN SECTION BOX:

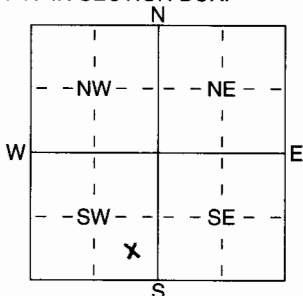

Depth(s) Groundwater Encountered 1 19.31 ft. 2 19.25 ft. 3 _____ ft.
WELL'S STATIC WATER LEVEL 19.31 ft. below land surface measured on mo/day/yr. 5/25/05
Pump test data: Well water was _____ ft. after _____ hours pumping _____ gpm
Est. Yield _____ gpm: Well water was _____ ft. after _____ hours pumping _____ gpm
WELL WATER TO BE USED AS:
1 Domestic 3 Feedlot 6 Oil field water supply 8 Air conditioning 11 Injection well
2 Irrigation 4 Industrial 7 Domestic (lawn & garden) 9 Dewatering 12 Other (Specify below)
10 Monitoring well MW 2A + 2B

Was a chemical/bacteriological sample submitted to Department? Yes No X ; If yes, mo/day/yr sample was submitted
Water Well Disinfected? Yes No X

5	TYPE OF BLANK CASING USED:
---	----------------------------

1 Steel	3 RMP (SR)
2 PVC	4 ABS

5 Wrought iron
6 Asbestos-Cement
7 Fiberglass

8 Concrete tile
9 Other (specify below)

CASING JOINTS: Glued Clamped
Welded
Threaded X

Blank casing diameter 2 in. to 30 ft., Dia 2 in. to 25 ft., Dia in. to ft.
Casing height above land surface flush in., weight lbs./ft. Wall thickness or gauge No.

TYPE OF SCREEN OR PERFORATION MATERIAL:

1 Steel	3 Stainless Steel
2 Brass	4 Galvanized Steel

5 Fiberglass
6 Concrete tile

GPVC

8 RMP (SR)
9 ABS

10 Asbestos-Cement
11 Other (Specify)
12 None used (open hole)

SCREEN OR PERFORATION OPENINGS ARE:

1 Continuous slot
2 Louvered shutter
3 Mill slot
4 Key punched

5 Guazed wrapped
6 Wire wrapped
7 Torch cut

8 Saw cut
9 Drilled holes
10 Other (specify) _____ ft
11 None (open hole)

SCREEN-PERFORATED INTERVALS: From 35 ft. to 30 ft., From _____ ft. to _____ ft.
From 25 ft. to 15 ft., From _____ ft. to _____ ft.

GRAVEL PACK INTERVALS: From 35 ft. to 28 ft., From _____ ft. to _____ ft.
From 25 ft. to 13 ft., From _____ ft. to _____ ft.

6 GROUT MATERIAL: 1 Neat cement 2 Cement grout 3 Bentonite 4 Other.....
Grout Intervals: From 28 ft. to 26 ft. From 13 ft. to 1 ft. From ft. to ft.

What is the nearest source of possible contamination:

1 Septic tank	4 Lateral lines
2 Sewer lines	5 Cess pool
3 Watertight sewer lines	6 Seepage pit

7 Pit privy
8 Sewage lagoon
9 Feedyard

10 Livestock pens	14 Abandoned water well
11 Fuel storage	15 Oil well/Gas well
12 Fertilizer storage	16 Other (specify below)
13 Insecticide storage	

Direction from well?

How many feet?

[illegible]

CONTRACTOR'S OR LANDOWNER'S CERTIFICATION: This water well was (1) constructed, (2) reconstructed, or (3) plugged under my jurisdiction and was completed on (mo/day/year) 5-24-05 and this record is true to the best of my knowledge and belief. Kansas Water Well Contractor's Licence No 704 This Water Well Record was completed on (mo/day/yr) 5-24-05 under the business name of MAX'S by (signature) David Smith