

1	LOCATION OF WATER WELL:	Fraction	Section Number	Township Number	Range Number
	County: <u>Sedgwick</u>	<u>NW</u> $\frac{1}{4}$ <u>SE</u> $\frac{1}{4}$ <u>SW</u> $\frac{1}{4}$	<u>33</u>	T <u>27</u> S	R <u>1</u> <u>EW</u>


Distance and direction from nearest town or city street address of well if located within city?

2] WATER WELL OWNER: Cintas Corporation  
RR#, St. Address, Box # : 2213 South Mead Street  
City, State, ZIP Code : Wichita, KS 67211

Board of Agriculture, Division of Water Resources  
Application Number:

3 LOCATE WELL'S LOCATION WITH AN "X" IN SECTION BOX:

4 DEPTH OF COMPLETED WELL 35 ft. ELEVATION: .....

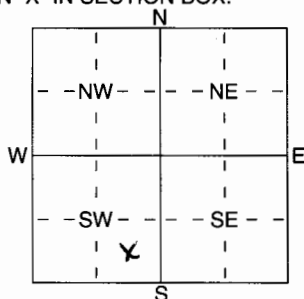

Depth(s) Groundwater Encountered 19.48 ft. 2 19.65 ft. 3 \_\_\_\_\_ ft.  
WELL'S STATIC WATER LEVEL 19.48 ft. below land surface measured on mo/day/yr 5/25/05  
Pump test data: Well water was \_\_\_\_\_ ft. after \_\_\_\_\_ hours pumping \_\_\_\_\_ gpm  
Est. Yield \_\_\_\_\_ gpm: Well water was \_\_\_\_\_ ft. after \_\_\_\_\_ hours pumping \_\_\_\_\_ gpm  
WELL WATER TO BE USED AS: 5 Public water supply 8 Air conditioning 11 Injection well  
1 Domestic 3 Feedlot 6 Oil field water supply 9 Dewatering 12 Other (Specify below)  
2 Irrigation 4 Industrial 7 Domestic (lawn & garden) 10 Monitoring well MW 1 & MW 1B

Was a chemical/bacteriological sample submitted to Department? Yes XXXX No XXXX; If yes, mo/day/yr sample was submitted  
Water Well Disinfected? Yes XXXX No XXXX

5	TYPE OF BLANK CASING USED:
---	----------------------------

5 Wrought iron

8 Concrete tile

CASING JOINTS: Glued ..... Clamped .....

1 Steel  
2 PVC  
3 RMP (SR)  
4 ABS

6 Asbestos-Cement  
7 Fiberglass

9 Other (specify below)

Welded .....

Blank casing diameter ..... 2" ..... in. to ..... 30' ..... ft., Dia ..... 2" ..... in. to ..... 15' ..... ft., Dia ..... in. to ..... ft.

Casing height above land surface ..... in., weight ..... lbs./ft. Wall thickness or gauge No. ....

TYPE OF SCREEN OR PERFORATION MATERIAL:

1 Steel  
2 Brass  
3 Stainless Steel  
4 Galvanized Steel

5 Fiberglass  
6 Concrete tile



## 10 Asbestos-Cement

SCREEN OR PERFORATION OPENINGS ARE:

1 Continuous slot  
2 Louvered shutter  
3 Mill slot  
4 Key punched

5 Guazed wrapped

6 Wire wrapped  
7 Torch cut

8 Saw cut

9 Drilled holes  
10 Other (specify)

11 None (open hole)

..... ft.

SCREEN-PERFORATED INTERVALS: From 35 ft. to 30 ft., From \_\_\_\_\_ ft. to \_\_\_\_\_ ft.

GRAVEL PACK INTERVALS: From 3.5 ft. to 28 ft. From \_\_\_\_\_ ft. to \_\_\_\_\_ ft.  
From 2.5 ft. to 13 ft. From \_\_\_\_\_ ft. to \_\_\_\_\_ ft.

6 GROUT MATERIAL: 1 Neat cement ☒ 2 Cement grout ☒ 3 Bentonite 4 Other .....

Grout Intervals: From 28 ft. to 26 ft., From 13 ft. to 1 ft., From ..... ft. to ..... ft.

What is the nearest source of possible contamination:

1 Septic tank	4 Lateral lines
2 Sewer lines	5 Cess pool
3 Watertight sewer lines	6 Seepage pit

7 Pit privy  
8 Sewage lagoon  
9 Feedyard

10 Livestock pens

11 Fuel storage  
12 Fertilizer storage  
13 Insecticide storage

14 Abandoned water well

15 Oil well/Gas well  
16 Other (specify below)

Direction from well?

How many feet?

[illegible]

7 CONTRACTOR'S OR LANDOWNER'S CERTIFICATION: This water well was (1) constructed, (2) reconstructed, or (3) plugged under my jurisdiction and was completed on (mo/day/year) 5-24-05 and this record is true to the best of my knowledge and belief. Kansas Water Well Contractor's Licence No. 704. This Water Well Record was completed on (mo/day/yr) 5-24-05 under the business name of Max by (signature) [Signature]