

WATER WELL PLUGGING RECORD

Form WWC-5P

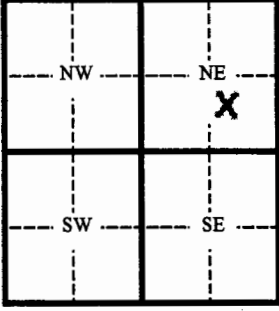
KSA 82a-1212

ID No.

1 LOCATION OF WATER WELL:	Fraction	Section Number	Township Number	Range Number
County: Sedgwick	NE ¼ SE ¼ NE ¼	9	27	01 E

Distance and direction from nearest town or city street address of well if located within city?
1100 E. 21st St. N., Wichita, KS

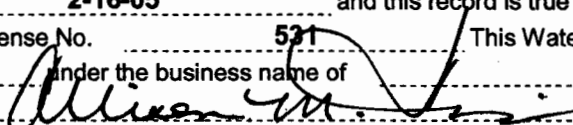
2 WATER WELL OWNER:	El Paso Corp.	Board of Agriculture, Division of Water Resources Application Number:
RR#, St. Address, Box #	2 N Nevada Ave.	
City, State, ZIP Code :	Colorado Springs, CO 80903	

3 MARK WELL'S LOCATION WITH AN "X" IN SECTION BOX:	4 DEPTH OF WELL 22 ft.												
	WELL'S STATIC WATER LEVEL Dry ft. WELL WAS USED AS: <table border="0"> <tr> <td>1 Domestic</td> <td>5 Public Water Supply</td> <td>9 Dewatering</td> </tr> <tr> <td>2 Irrigation</td> <td>6 Oil Field Water Supply</td> <td>10 Monitoring Well</td> </tr> <tr> <td>3 Feedlot</td> <td>7 Lawn and Garden (domestic)</td> <td>11 Injection Well</td> </tr> <tr> <td>4 Industrial</td> <td>8 Air Conditioning</td> <td>12 Other</td> </tr>
Was a chemical/bacteriological sample submitted to Department? Yes ___ No X If yes, mo/day/yr sample was submitted _____ Water Well Disinfected: Yes ___ No X													

5 TYPE OF BLANK CASING USED:	1 Steel	3 RMP (SR)	5 Wrought	7 Fiberglass	9 Other (specify below)
	2 PVC	4 ABC	6 Asbestos-Cement	8 Concrete Tile	
Blank casing diameter 4 in. Was casing pulled? Yes ___ No X If yes, how much _____					
Casing height above or below land surface 0 in. Overdrilled from 0 to 22 ft. below ground surface.					

6 GROUT PLUG MATERIAL:	1 Neat cement	2 Cement grout	3 Bentonite	4 Other
Grout Plug Intervals From 0 ft. to 22 ft. From _____ ft. to _____ ft. From _____ ft. to _____ ft.				
What is the nearest source of possible contamination:				
1 Septic tank	6 Seepage pit	11 Fuel storage	16 Other (specify below)	
2 Sewer lines	7 Pit privy	12 Fertilizer storage		
3 Watertight sewer lines	8 Sewage lagoon	13 Insecticide storage		
4 Lateral lines	9 Feedyard	14 Abandoned water well		
5 Cess Pool	10 Livestock pens	15 Oil well/ Gas well		
Direction from well? _____		How many feet? _____		

FROM	TO	CODE	PLUGGING MATERIALS
0	22		Bentonite Grout

by (signature) 

INSTRUCTIONS: Please fill in blanks and circle the correct answers. Send three copies to Kansas Department of Health and Environment, Bureau of Water, 1000 S W Jackson St., Ste. 420, Topeka, Kansas 66620-0001. Telephone: 785-296-3565. Send one to Water Well Owner and retain one for your records.