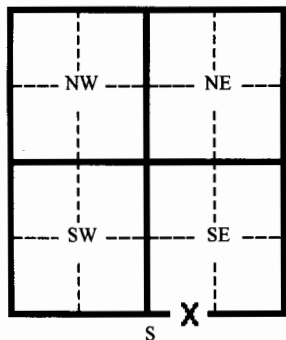


1 LOCATION OF WATER WELL:	Fraction	Section Number	Township Number	Range Number
County: Sedgwick	SE 1/4 SW 1/4 SE 1/4	30	27	1-East

Distance and direction from nearest town or city street address of well if located within city?

1624 W. Harry, Wichita, Kansas

2 WATER WELL OWNER: Richard Ott	Board of Agriculture, Division of Water Resources
RR#, St. Address, Box # 1617 W. Harry	Application Number:
City, State, ZIP Code : Wichita, Kansas 67213	

3 MARK WELL'S LOCATON WITH AN "X" IN SECTION BOX:	4 DEPTH OF WELL 20.0 ft.
	WELL'S STATIC WATER LEVEL 12.83 ft.
	WELL WAS USED AS:
	1 Domestic 5 Public Water Supply 9 Dewatering 2 Irrigation 6 Oil Field Water Supply 10 Monitoring Well 3 Feedlot 7 Lawn and Garden (domestic) 11 Injection Well 4 Industrial 8 Air Conditioning 12 Other
	Was a chemical/bacteriological sample submitted to Department? Yes _____ No X
	If yes, mo/day/yr sample was submitted _____
	Water Well Disinfected: Yes _____ No X

5 TYPE OF BLANK CASING USED:	1 Steel	3 RMP (SR)	5 Wrought	7 Fiberglass	9 Other (specify below)
	2 PVC	4 ABC	6 Asbestos-Cement	8 Concrete Tile	
Blank casing diameter 2.375 in.	Was casing pulled? Yes X No _____	If yes, how much? _____			
Casing height above or below land surface Unknown in.		Well overdrilled to 20'			

6 GROUT PLUG MATERIAL:	1 Neat cement	2 Cement grout	3 Bentonite	4 Other	Soils
Grout Plug Intervals From 20.0 ft. to 3.0 ft. From 3.0 ft. to 0.0 ft. From _____ ft. to _____ ft.					
What is the nearest source of possible contamination:					
1 Septic tank	6 Seepage pit	11 Fuel storage (former)	16 Other (specify below)		
2 Sewer lines	7 Pit privy	12 Fertilizer storage			
3 Watertight sewer lines	8 Sewage lagoon	13 Insecticide storage			
4 Lateral lines	9 Feedyard	14 Abandoned water well			
5 Cess Pool	10 Livestock pens	15 Oil well/ Gas well			
Direction from well? N/A	How many feet? 0				

FROM	TO	CODE	PLUGGING MATERIALS
0.0	3.0		Compacted soils
3.0	20.0		Bentonite chips

7 CONTRACTOR'S OR LANDOWNER'S CERTIFICATION: This water well was plugged under my jurisdiction and was completed on (mo/day/yr) 06/20/05 and this record is true to the best of my knowledge and belief. Kansas
Water Well Contractor's License No. 692 This Water Well Record was completed on (mo/day/yr) 06/27/05
by (signature) <i>[Signature]</i> under the business name of Quad State Services, Inc.

INSTRUCTIONS: Please fill in blanks and circle the correct answers. Send three copies to Kansas Department of Health and Environment, Bureau of Water, 1000 S W Jackson St., Ste. 420, Topeka, Kansas 66620-0001. Telephone: 785-296-3565. Send one to Water Well Owner and retain one for your records.