


WATER WELL RECORD Form WWC-5 KSA 82a-1212

1 LOCATION OF WATER WELL: Fraction SE 1/4 NE 1/4 NE 1/4 Section Number 29 Township Number T 27 S Range Number R 1 EW
 County: Sedgwick
 Distance and direction from nearest town or city street address of well if located within city?

921 South Broadway, Wichita, Kansas

2 WATER WELL OWNER: Town & Country Markets 01948035 MW-3
 RR#, St. Address, Box #: P.O. Box 17087 Board of Agriculture, Division of Water Resources
 City, State, ZIP Code: Wichita, Kansas 67217 Application Number:

3 LOCATE WELL'S LOCATION WITH AN "X" IN SECTION BOX:

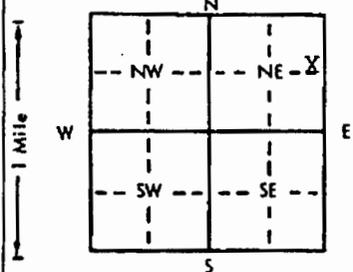

4 DEPTH OF COMPLETED WELL: 22 ft. ELEVATION: APPROX. 1295.0
 Depth(s) Groundwater Encountered 1. 16.5 ft. 2. ft. 3. ft.
 WELL'S STATIC WATER LEVEL: 16.01 ft. below land surface measured on mo/day/yr 10/28/94
 Pump test data: Well water was ft. after hours pumping gpm
 Est. Yield .N/A. gpm: Well water was ft. after hours pumping gpm
 Bore Hole Diameter: 8.25 in. to 22 ft., and in. to ft.
 WELL WATER TO BE USED AS:
 1 Domestic 3 Feedlot 6 Oil field water supply 9 Dewatering 12 Other (Specify below)
 2 Irrigation 4 Industrial 7 Lawn and garden only 10 Monitoring well
 Was a chemical/bacteriological sample submitted to Department? Yes.....No...X..... If yes, mo/day/yr sample was submitted Water Well Disinfected? Yes No X

5 TYPE OF BLANK CASING USED:
 1 Steel 3 RMP (SR) 5 Wrought iron 8 Concrete tile CASING JOINTS: Glued Clamped
 2 PVC 4 ABS 6 Asbestos-Cement 9 Other (specify below) Welded
 Blank casing diameter 2 in. to 12 ft., Dia in. to ft., Dia in. to ft.
 Casing height above land surface: 3 in., weight lbs/ft. Wall thickness or gauge No. Schedule 40
 TYPE OF SCREEN OR PERFORATION MATERIAL: 7 PVC 10 Asbestos-cement
 1 Steel 3 Stainless steel 5 Fiberglass 8 RMP (SR) 11 Other (specify)
 2 Brass 4 Galvanized steel 6 Concrete tile 9 ABS 12 None used (open hole)
 SCREEN OR PERFORATION OPENINGS ARE:
 1 Continuous slot 3 Mill slot 5 Gauzed wrapped 8 Saw cut 11 None (open hole)
 2 Louvered shutter 4 Key punched 6 Wire wrapped 9 Drilled holes
 7 Torch cut 10 Other (specify)
 SCREEN-PERFORATED INTERVALS: From 12.0 ft. to 22.0 ft., From ft. to ft.
 GRAVEL PACK INTERVALS: From 10.0 ft. to 22.0 ft., From ft. to ft.

6 GROUT MATERIAL: 1 Neat cement 2 Cement grout 3 Bentonite 4 Other
 Grout intervals: From 0 ft. to 8 ft., From 8 ft. to 10 ft., From ft. to ft.
 What is the nearest source of possible contamination:
 1 Septic tank 4 Lateral lines 7 Pit privy 10 Livestock pens 14 Abandoned water well
 2 Sewer lines 5 Cess pool 8 Sewage lagoon 11 Fuel storage 15 Oil well/Gas well
 3 Watertight sewer lines 6 Seepage pit 9 Feedyard 12 Fertilizer storage 16 Other (specify below)
 13 Insecticide storage UST

FROM	TO	LITHOLOGIC LOG	FROM	TO	PLUGGING INTERVALS
0.0	0.5	Asphalt	0	22	Bentonite
0.5	10.0	Brown and Dark Brown, Sandy Lean Clay			Plugged 9-5-00 by Thornburg Contract Drilling (# 654)
10.0	22.0	Brown, Fine to Medium Sand			

RECEIVED

SEP 18 2000

BUREAU OF WATER

7 CONTRACTOR'S OR LANDOWNER'S CERTIFICATION: This water well was 1 constructed, (2) reconstructed, or (3) plugged under my jurisdiction and was completed on (mo/day/yr) 10/19/94 and this record is true to the best of my knowledge and belief. Kansas Water Well Contractor's License No. 416 This Water Well Record was completed on (mo/day/yr) 10/19/94
 under the business name of Terracon Consultants, Inc. by (signature) Steve Fischer

INSTRUCTIONS: Use typewriter or ball point pen. PLEASE PRESS FIRMLY and PRINT clearly. Please fill in blanks, underline or circle the correct answers. Send top three copies to Kansas Department of Health and Environment, Bureau of Water, Topeka, Kansas 66620-0001. Telephone: 913-296-5545. Send one to WATER WELL OWNER and retain one for your records.

Amended Report



State of Kansas

Site I.D. Form

a. County: Sedgwick b. Site I.D. number: 00105967

c. Owner Name: Town & Country Markets

d. Owner Address: PO 17087 City Wichita State KS Zip Code 67217

e. This site is located at (66 characters max.) 921 S. Broadway Wichita, KS

f. Encoded Owner Name: TOWNCOUNTRY g. Well (site) Number: 003

h. Encoding Scheme (Circle only one number): 1. If city owned... 2. If County owned... 3. If business owned... 4. If owned by an individual... 5. If none of the above apply...

i. This well (site) is in Sec. 29, Twn. 27, Rng. 1 (circle one) E/W. From the (circle one) NE / SW / SE / NW corner of this section, this site is 1369.995 ft (circle one) N/S and 118.104 ft (circle one) E/W and is in the NE 1/4 of the SE 1/4 of the NE 1/4.

j. Measurement Method Used (circle only one number): 1. Legal Survey 2. Absolute Survey 3. GPS Survey 4. Technical Survey 5. Compass & Chain 6. Hand Wheel 7. USGS 7.5' Topomap 8. County Road Map 9. Other:

k. Measured By: Rathbone, D of (kk) N/A (Agency), N/A (Bureau)

l. The tag is attached to the casing, (ll.) using strap

m. Water Source (circle only one number): 1. Well 2. Spring 3. Pit 4. Lake / Pond 5. Stream / River 6. Ditch / Canal 7. Storm Runoff 8. Treated Water (Distribution System) 9. Waste water

n. Use(s) of Water (circle all that apply): 1. Domestic 2. Irrigation 3. Feedlot 4. Industrial 5. Public Water Supply 6. Oil Field Water Supply 7. Lawn and Garden Only 8. Air Conditioning 9. Dewatering 10. Monitoring Well Only 11. Injection Well 12. Artificial Recharge 13. Recreation 14. Other (Specify):

o. Type of Casing (circle only one number): 1. Steel 2. PVC 3. RMP (SR) 4. ABS 5. Wrought Iron 6. Asbestos Cement 7. Fiberglass 8. Concrete Tile 9. Other (specify or write "UNK" if unknown):

p. Form Completed By: VAI, W of (pp.) N/A (Agency), N/A (Bureau)

q. Your Work Phone Number: (316) - 262 - 0171 qq. Date: 2 - 7 - 95

r. Program Code: EP ER EE EU EL (E) EJ SC SG SN SW SE SP FK LM ES AR KC PU PC PT PE PD PV PI WI WE PP HL HD HF HS WC RP GS US

s. Project Code: 020871176

t. Optional "well number codes": Consultant Code V, and / or (S)hallow, (I)ntermediate, or (D)eep S.

u. Well Depth (TOC to TD): ft. v. TOC is ft. above/below ground elevation. w. TOC Elevation: 1295.48 ft.

x. DWR File Number: xx. Is this a replacement well (circle one)? Yes (No)

Comments: Macon Company Plugged 9-8-00 by Thorburg Contract Drilling #654 (No well ID Tag) PP - Terracon Environmental