


1 LOCATION OF WATER WELL:	Fraction	Section Number	Township Number	Range Number
County: Sedgwick	NW ¼ NW ¼ NW ¼	33	T 27 S	R 1 E/W

1606 S. Broadway, Wichita

Board of Agriculture, Division of Water Resources
Application Number:

4 DEPTH OF COMPLETED WELL 27 ft. ELEVATION:
 Depth(s) Groundwater Encountered 1. ft. 2. ft. 3. ft.
 WELL'S STATIC WATER LEVEL ft. below land surface measured on mo/day/yr
 Pump test data: Well water was NA ft. after hours pumping gpm
 Est. Yield .. NA .. gpm: Well water was ft. after hours pumping gpm
 Bore Hole Diameter 8. in. to 27 ft., and. in. to ft.
 WELL WATER TO BE USED AS: 5 Public water supply 8 Air conditioning 11 Injection well
 1 Domestic 3 Feedlot 6 Oil field water supply 9 Dewatering 12 Other (Specify below)
 2 Irrigation 4 Industrial 7 Lawn and garden only 10 Monitoring well
 Was a chemical/bacteriological sample submitted to Department? Yes.....No✓...; If yes, mo/day/yr sample was submitted
 Water Well Disinfected? Yes No✓

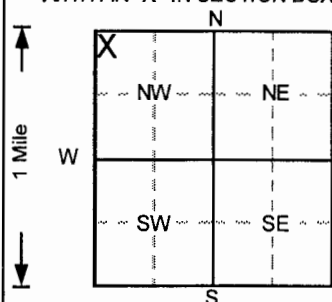

5 TYPE OF BLANK CASING USED:

1 Steel	3 RMP (SR)	5 Wrought iron	8 Concrete tile	CASING JOINTS: Glued Clamped
2 PVC	4 ABS	6 Asbestos-Cement	9 Other (specify below)	Welded
		7 Fiberglass		Threaded. <input checked="" type="checkbox"/>

Blank casing diameter 2 in. to 17 ft., Dia in. to ft., Dia in. to ft.

Casing height above land surface 0 in., weight lbs./ft. Wall thickness or gauge No. Sch. 40

TYPE OF SCREEN OR PERFORATION MATERIAL

1 Steel	3 Stainless steel	5 Fiberglass	7 PVC	10 Asbestos-cement
2 Brass	4 Galvanized steel	6 Concrete tile	8 RMP (SR)	11 Other (specify)
			9 ABS	12 None used (open hole)

SCREEN OR PERFORATION OPENINGS ARE:

1 Continuous slot	3 Mill slot	5 Gauzed wrapped	8 Saw cut	11 None (open hole)
2 Louvered shutter	4 Key punched	6 Wire wrapped	9 Drilled holes	
		7 Torch cut	10 Other (specify)	

SCREEN-PERFORATED INTERVALS: From 17 ft. to 27 ft. From ft. to ft. to ft.

GRAVEL PACK INTERVALS: From 15 ft. to 27 ft. From ft. to ft. to ft.

From ft. to ft. From ft. to ft.

6] GROUT MATERIAL:		1 Neat cement	2 Cement grout	3 Bentonite	4 Other Concrete
Grout Intervals:		From 0 ft. to 1 ft.	From 1 ft. to 15 ft.	From 15 ft. to 15 ft.	
What is the nearest source of possible contamination:					
1 Septic tank	4 Lateral lines	7 Pit privy	10 Livestock pens	14 Abandoned water well	
2 Sewer lines	5 Cess pool	8 Sewage lagoon	11 Fuel storage	15 Oil well/Gas well	
3 Watertight sewer lines	6 Seepage pit	9 Feedyard	12 Fertilizer storage	16 Other (specify below)	
			13 Insecticide storage		
Direction from well?			How many feet?		

FROM	TO	LITHOLOGIC LOG	FROM	TO	PLUGGING INTERVALS
0	0.5	Asphalt,			
0.5	6	Clay, v. silty, moist, plastic, Brown			
6	11	Sand (vf-m) w/clay silt stringers, moist, Brow			
11	14	Sand (f-c) w/f gravel, subrounded, Brown			
14	18	Sand (vf-m), v. sl. moist, Lt. Grayish Brown			
18	22	Sand (f-c) w/f gravel, subrounded, Lt. Grayish			
22	27	Sand (f-c) w/f gravel, subrounded, Brown			
					MW17 , Tag # 00372187 , Flushmount
					Project Name: GF - Kwik Shop #726 (Former)
					GeoCore # 1286 , KDHE # U2 087 01278

7 CONTRACTOR'S OR LANDOWNER'S CERTIFICATION: This water well was (1) constructed, (2) reconstructed, or (3) plugged under my jurisdiction and was completed on (mo/day/year) 6/28/2006 and this record is true to the best of my knowledge and belief.
Kansas Water Well Contractor's License No. 527 This Water Well Record was completed on (mo/day/yr) 7/21/06
under the business name of GeoCore, Inc. by (signature) [Signature]

INSTRUCTIONS: Use typewriter or ball point pen. PLEASE PRESS FIRMLY and PRINT clearly. Please fill in blanks, underline or circle the correct answers. Send top three copies to Kansas Department of Health and Environment, Bureau of Water, Topeka, Kansas 66620-0001. Telephone: 913-296-5545. Send one to WATER WELL OWNER and retain one for your records.