


1 LOCATION OF WATER WELL: Fraction NE SW SE Section Number 30 Township Number 27S Range Number 1 0
 County: Sedgwick

Distance and direction from nearest town or city street address of well if located within city?
1630 W Harry

2 WATER WELL OWNER: ~~AAA~~ KDHE BER
 RR #, St. Address, Box #: AAA U208711773 Board of Agriculture, Division of Water Resources Application Number: MW1
 City, State, ZIP Code :

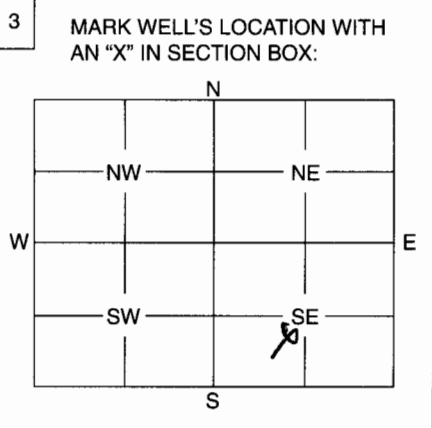

4 DEPTH OF WELL 18 ft.
 WELL'S STATIC WATER LEVEL ft.
 WELL WAS USED AS:
 1 Domestic 5 Public Water Supply 9 Dewatering
 2 Irrigation 6 Oil Field Water Supply 10 Monitoring Well
 3 Feedlot 7 Domestic (Lawn & Garden) 11 Injection Well
 4 Industrial 8 Air Conditioning 12 Other
 Was a chemical / bacteriological sample submitted to Department? Yes No X
 If yes, mo/day/yr sample was submitted
 Water Well Disinfected: Yes No X

5 TYPE OF BLANK CASING USED:
 1 Steel 3 RMP (SR) 5 Wrought 7 Fiberglass 9 Other (Specify below)
 2 PVC 4 ABS 6 Asbestos-Cement 8 Concrete Tile
 Blank casing diameter 2 in. Was casing pulled? Yes X No If yes, how much 16.10
 Casing height above or below land surface in.

6 GROUT PLUG MATERIAL: 1 Neat cement 2 Cement grout 3 Bentonite 4 Other
 Grout Plug Intervals: From 3 ft. to 18 ft., From ft. to ft., From to ft.
 What is the nearest source of possible contamination:
 1 Septic tank 6 Seepage pit 11 Fuel storage 16 Other (specify below)
 2 Sewer lines 7 Pit privy 12 Fertilizer storage
 3 Watertight sewer lines 8 Sewage lagoon 13 Insecticide storage
 4 Lateral lines 9 Feedyard 14 Abandoned water well
 5 Cess pool 10 Livestock pens 15 Oil well/Gas well
 Direction from well? How many feet?

FROM	TO	PLUGGING MATERIALS
<u>0</u>	<u>1</u>	<u>Concrete</u>
<u>1</u>	<u>3</u>	<u>Soil</u>
<u>3</u>	<u>18</u>	<u>Bentonite</u>

7 CONTRACTOR'S OR LANDOWNER'S CERTIFICATION: This water well was plugged under my jurisdiction and was completed on (mo/day/year) 7/20/16 and this record is true to the best of my knowledge and belief. Kansas Water Well Contractor's License No. 767 This Water Well Record was completed on (mo/day/year) 7/18/16 under the business name of Larsen & Associates by (signature) Vicky Larson