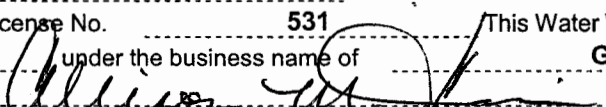


WATER WELL PLUGGING RECORD

Form WWC-5P

KSA 82a-1212

ID No. 00119829

1 LOCATION OF WATER WELL: Fraction		Section Number		Township Number		Range Number																													
County: Sedgwick		SE ¼ SE ¼ SW ¼		33		27S 1E																													
Distance and direction from nearest town or city street address of well if located within city? 906 E. Pawnee, Wichita, KS																																			
2 WATER WELL OWNER: Town & Country Markets																																			
RR#, St. Address, Box # : 1522 S. Florence				Board of Agriculture, Division of Water Resources																															
City, State, ZIP Code : Wichita, KS 67209				Application Number:																															
3 MARK WELL'S LOCATION WITH AN "X" IN SECTION BOX:		4 DEPTH OF WELL 22.02 ft.																																	
<div style="text-align: center;">N <table border="1" style="margin: auto; border-collapse: collapse;"><tr><td style="width: 50px; height: 50px;"></td><td style="width: 50px; height: 50px;"></td></tr><tr><td style="width: 50px; height: 50px; text-align: center;">NW</td><td style="width: 50px; height: 50px; text-align: center;">NE</td></tr><tr><td style="width: 50px; height: 50px;"></td><td style="width: 50px; height: 50px;"></td></tr><tr><td style="width: 50px; height: 50px; text-align: center;">SW</td><td style="width: 50px; height: 50px; text-align: center;">SE</td></tr><tr><td style="width: 50px; height: 50px; text-align: center;">X</td><td style="width: 50px; height: 50px;"></td></tr></table> S</div>				NW	NE			SW	SE	X		WELL'S STATIC WATER LEVEL 18.03 ft.																							
		NW	NE																																
SW	SE																																		
X																																			
WELL WAS USED AS:																																			
<div style="display: flex; justify-content: space-between;"><div>1 Domestic 2 Irrigation 3 Feedlot 4 Industrial</div><div>5 Public Water Supply 6 Oil Field Water Supply 7 Lawn and Garden (domestic) 8 Air Conditioning</div><div>9 Dewatering 10 Monitoring Well 11 Injection Well 12 Other</div></div>																																			
Was a chemical/bacteriological sample submitted to Department? Yes <input type="checkbox"/> No <input checked="" type="checkbox"/>																																			
If yes, mo/day/yr sample was submitted _____																																			
Water Well Disinfected: Yes <input type="checkbox"/> No <input checked="" type="checkbox"/>																																			
5 TYPE OF BLANK CASING USED:																																			
<div style="display: flex; justify-content: space-between;"><div>1 Steel 2 PVC</div><div>3 RMP (SR) 4 ABC</div><div>5 Wrought 6 Asbestos-Cement</div><div>7 Fiberglass 8 Concrete Tile</div><div>9 Other (specify below)</div></div>																																			
Blank casing diameter 2 in. Was casing pulled? Yes <input type="checkbox"/> No <input checked="" type="checkbox"/> If yes, how much _____																																			
Casing height above or below land surface 2.02 in. Overdrilled to 20ft. below ground surface																																			
6 GROUT PLUG MATERIAL: 1 Neat cement 2 Cement grout 3 Bentonite 4 Other Concrete																																			
Grout Plug Intervals From 22.02 ft. to 2 ft. From 2 ft. to 0 ft. From _____ ft. to _____ ft.																																			
What is the nearest source of possible contamination:																																			
<div style="display: flex; justify-content: space-between;"><div>1 Septic tank 2 Sewer lines 3 Watertight sewer lines 4 Lateral lines 5 Cess Pool</div><div>6 Seepage pit 7 Pit privy 8 Sewage lagoon 9 Feedyard 10 Livestock pens</div><div>11 Fuel storage 12 Fertilizer storage 13 Insecticide storage 14 Abandoned water well 15 Oil well/ Gas well</div><div>16 Other (specify below) _____</div></div>																																			
Direction from well? _____ How many feet? _____																																			
<table border="1" style="width:100%; border-collapse: collapse;"><thead><tr><th>FROM</th><th>TO</th><th>CODE</th><th>PLUGGING MATERIALS</th></tr></thead><tbody><tr><td>0</td><td>2</td><td></td><td>Concrete</td></tr><tr><td>2</td><td>22.02</td><td></td><td>Bentonite</td></tr><tr><td> </td><td> </td><td> </td><td> </td></tr><tr><td> </td><td> </td><td> </td><td> </td></tr><tr><td> </td><td> </td><td> </td><td> </td></tr><tr><td> </td><td> </td><td> </td><td> </td></tr></tbody></table>								FROM	TO	CODE	PLUGGING MATERIALS	0	2		Concrete	2	22.02		Bentonite																
FROM	TO	CODE	PLUGGING MATERIALS																																
0	2		Concrete																																
2	22.02		Bentonite																																
7 CONTRACTOR'S OR LANDOWNER'S CERTIFICATION: This water well was plugged under my jurisdiction and was completed on (mo/day/yr) 10/12/06 and this record is true to the best of my knowledge and belief. Kansas Water Well Contractor's License No. 531 This Water Well Record was completed on (mo/day/yr) 10/13/06 under the business name of Geotechnical Services Inc. by (signature) 																																			
INSTRUCTIONS: Please fill in blanks and circle the correct answers. Send three copies to Kansas Department of Health and Environment, Bureau of Water, 1000 S W Jackson St., Ste. 420, Topeka, Kansas 66620-0001. Telephone: 785-296-3565. Send one to Water Well Owner and retain one for your records.																																			