WATER WELL RECORD Form WWC-5 KSA 82a-1212 ID No. MW-19

1 LOCATION OF WATER WELL:	Fraction	Section Number	Township Number	Range Number
County: Sedgwick	NW ¼ NW ¼ NE ¼	7	T 27 (S)	R 1 (E) W

Distance and direction from nearest town or city street address of well if located within city? Coastal Mart #9157 1925 W. 21st St. North Wichita, KS 67203

2 WATER WELL OWNER: Conoco Phillips - Becky Hesslen
RR#, St. Address, Box # : 1234 Phillips Bldg.
City, State, ZIP Code : Bartlesville, OK 74004
Board of Agriculture, Division of Water Resources Application Number:

3 LOCATE WELL'S LOCATION WITH AN "X" IN SECTION BOX:

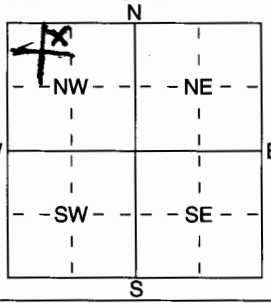

4 DEPTH OF COMPLETED WELL 30.0 ft. ELEVATION:
Depth(s) Groundwater Encountered 1 ..... ft. 2 ..... ft. 3 ..... ft.
WELL'S STATIC WATER LEVEL 20.30 ft. below land surface measured on mo/day/yr .....
Pump test data: Well water was ..... ft. after ..... hours pumping ..... gpm
Est. Yield ..... gpm: Well water was ..... ft. after ..... hours pumping ..... gpm
WELL WATER TO BE USED AS: 5 Public water supply 8 Air conditioning 11 Injection well
1 Domestic 3 Feedlot 6 Oil field water supply 9 Dewatering 12 Other (Specify below)
2 Irrigation 4 Industrial 7 Domestic (lawn & garden) (10) Monitoring well .....

Was a chemical/bacteriological sample submitted to Department? Yes (No); If yes, mo/day/yrs sample was submitted
Water Well Disinfected? Yes (No)

5 TYPE OF BLANK CASING USED: 5 Wrought iron 8 Concrete tile CASING JOINTS: Glued ..... Clamped .....
1 Steel 3 RMP (SR) 6 Asbestos-Cement 9 Other (specify below) Welded .....
(2) PVC 4 ABS 7 Fiberglass ..... Threaded X
Blank casing diameter 2" in. to 10' ft., Dia ..... in. to ..... ft., Dia ..... in. to ..... ft.
Casing height above land surface Flush in., weight ..... lbs./ft. Wall thickness or guage No. Sch. 40

TYPE OF SCREEN OR PERFORATION MATERIAL:
1 Steel 3 Stainless Steel 5 Fiberglass (7) PVC 10 Asbestos-Cement
2 Brass 4 Galvanized Steel 6 Concrete tile 8 RMP (SR) 11 Other (Specify) .....
9 ABS 12 None used (open hole)

SCREEN OR PERFORATION OPENINGS ARE:
1 Continuous slot (3) Mill slot 5 Guazed wrapped 8 Saw cut 11 None (open hole)
2 Louvered shutter 4 Key punched 6 Wire wrapped 9 Drilled holes
7 Torch cut 10 Other (specify) ..... ft.

SCREEN-PERFORATED INTERVALS: From 10 ft. to 30 ft., From ..... ft. to ..... ft.
From ..... ft. to ..... ft., From ..... ft. to ..... ft.
GRAVEL PACK INTERVALS: From 8 ft. to 30 ft., From ..... ft. to ..... ft.
From ..... ft. to ..... ft., From ..... ft. to ..... ft.

6 GROUT MATERIAL: 1 Neat cement 2 Cement grout (3) Bentonite 4 Other .....
Grout Intervals: From 1 ft. to 8 ft., From ..... ft. to ..... ft., From ..... ft. to ..... ft.

What is the nearest source of possible contamination:
1 Septic tank 4 Lateral lines 7 Pit privy 10 Livestock pens 14 Abandoned water well
2 Sewer lines 5 Cess pool 8 Sewage lagoon (11) Fuel storage 15 Oil well/Gas well
3 Watertight sewer lines 6 Seepage pit 9 Feedyard 12 Fertilizer storage 16 Other (specify below)
13 Insecticide storage .....
Direction from well? How many feet? 350'

FROM	TO	LITHOLOGIC LOG	FROM	TO	PLUGGING INTERVALS
		See Boring Log			

7 CONTRACTOR'S OR LANDOWNER'S CERTIFICATION: This water well was (1) constructed, (2) reconstructed, or (3) plugged under my jurisdiction and was completed on (mo/day/year) 10-19-06 and this record is true to the best of my knowledge and belief. Kansas Water Well Contractor's Licence No 606 This Water Well Record was completed on (mo/day/yr) 11-2-06
under the business name of PSA Environmental by (signature)

INSTRUCTIONS: Use typewriter or ball point pen. *PLEASE PRESS FIRMLY* and *PRINT* clearly. Please fill in blanks, underline or circle the correct answers. Send top three copies to Kansas Department of Health and Environment, Bureau of Water, Geology Section, 1000 SW Jackson St., Suite 420, Topeka, Kansas 66612-1367. Telephone 785-296-5522. Send one to WATER WELL OWNER and retain one for your records. Fee of $5.00 for each constructed well.

PROJECT: NAME: Conoco 9157

MONITORING WELL/BORING NO. MW-19

LOCATION: SE of Site @ corner of Blockbuster

DRILL EQUIPMENT: Geoprobe

DRILLING METHOD: HSA

DRILLED BY: Aaron OFFICE: PSA

LOGGED BY: Brad H OFFICE: TT

REMARKS:

TOP OF HOLE ELEV. (ft):

GROUNDWATER ELEV. (DATE) (ft):

STARTED: DATE: 10/19 TIME: 1130

COMPLETED: DATE: 10/19 TIME: 1230

DEPTH (ft)	LEGEND	CLASSIFICATION AND DESCRIPTION	SAMPLE SYMBOL	PENET. RESIST. (BLOWS/ft)	FIELD SCREENING RESULTS: HNU (PID) HEADSPACE	OVA (FID) HEADSPACE	ODOR	STAINING
0.0		Brown Silty fine Sand			0.0			
5.0		Brown Silty fine Sand			0.1			
10.0		Brown Silty fine Sand			0.1			
15.0		Brown Clayey fine Sand			0.1			
20.0		Brown Clayey fine Sand			0.1			
25.0		Brown Clayey fine Sand			0.1			
30.0								
35.0								

CAL = CALIFORNIA
SS = SPLIT SPOON
ST = SHELBY TUBE
DB = DISTURBED BULK /BAG SAMPLE

CON = CONTINUOUS SAMPLE
CORE = CORE SAMPLE
CA = SAMPLE SUBMITTED FOR CHEMICAL ANALYSIS
"-" = NOT ANALYZED

NS = NO SHEEN
SS = SLIGHT SHEEN
MS = MODERATE SHEEN
HS = HEAVY SHEEN

DEPTH TO BOTTOM OF BORING 30.0'

PROJECT NO.	MAXIM TECHNOLOGIES INC	FIELD LOG OF EXPLORATORY BORING NO. MW-19	SHEET 1 OF 1