

WATER WELL PLUGGING RECORD Form WWC-5P

KSA 82a-1212

ID NO.

Don MW4
00090713

1 LOCATION OF WATER WELL: Fraction SE SE NE Section Number 22 Township Number 27 Range Number 1 E/W
 County: Sedgwick NE 1/4 SE 1/4 SW 1/4

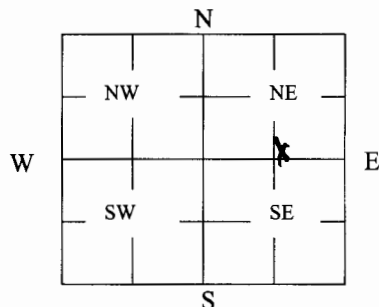
Distance and direction from nearest town or city street address of well if located within city?

145 N. Hillside Wichita, KS2 WATER WELL OWNER: Pat DonovanRR#, St. Address, Box #: 24125 BonnCity, State ZIP Code: Wichita, KS 67217

Global Positioning Systems (decimal degrees, min. of 4 digits)

Latitude: 37°N, 41' 16.433"Longitude: 97°W, 17' 56.023"Elevation: 1320Datum: NAD 27Data Collection Method: USGS Topo Map

3 MARK WELL'S LOCATION WITH AN "X" IN SECTION BOX:

4 DEPTH OF WELL 45 ft.WELL'S STATIC WATER LEVEL NA ft

WELL WAS USED AS:

- 1 Domestic
2 Irrigation
3 Feedlot
4 Industrial

- 5 Public Water Supply
6 Oil Field Water Supply
7 Domestic (Lawn & Garden)
8 Air Conditioning

- 9 Dewatering
10 Monitoring
11 Injection Well
12 Other

Was a chemical/bacteriological sample submitted to Department? Yes No X

5 TYPE OF BLANK CASING USED:

1 Steel

3 RMP (SR)

5 Wrought

7 Fiberglass

9 Other (Specify below)

2 PVC

4 ABS

6 Asbestos-Cement

8 Concrete Tile

Blank casing diameter 3 in. Was casing pulled? Yes X No If yes, how much 3 feet
 Casing height above or below land surface 36 in.

6 GROUT PLUG MATERIAL: 1 Neat cement 2 Cement grout 3 Bentonite 4 Other Grout Plug Intervals: From 45 ft. to 3 ft., From ft. to ft., From to ft.

What is the nearest source of possible contamination:

1 Septic tank

6 Seepage pit

11 Fuel Storage

16 Other (specify below)

2 Sewer lines

7 Pit privy

12 Fertilizer storage

3 Watertight sewer lines

8 Sewage lagoon

13 Insecticide storage

4 Lateral lines

9 Feedyard

14 Abandoned water well

Direction from well? Southeast

5 Cess pool

10 Livestock pens

15 Oil well/Gas well

How many feet? 65

FROM	TO	PLUGGING MATERIALS	FROM	TO	PLUGGING MATERIALS
<u>45</u>	<u>3</u>	<u>bentonite grout</u>			
<u>3</u>	<u>0</u>	<u>native material</u>			

7 CONTRACTOR'S OR LANDOWNER'S CERTIFICATION: This water well was plugged under my jurisdiction and was completed on (mo/day/year) 12/5/2006 and this record is true to the best of my knowledge and belief. Kansas Water Well Contractor's License No. 594. This Water Well Record was completed on (mo/day/year) 12/18/2006 under the business name of Coranco great Plains Inc by (signature) Tim J. Miller

INSTRUCTIONS: Use typewriter or ballpoint pen. Please press firmly and print clearly. Please fill in blanks, underline or circle the correct answers. Send top three copies to Kansas Department of Health and Environment, Bureau of Water, Geology Section, 1000 SW Jackson St., Ste. 420, Topeka, Kansas 66612-1367. Telephone: 785/296-5522. Send one to Water Well Owner and retain one for your records. Visit us at <http://www.kdheks.gov/geo/waterwells>.