

WATER WELL PLUGGING RECORD Form WWC-5P

KSA 82a-1212

ID NO.

TAC MW1

00118758

1 LOCATION OF WATER WELL: Fraction NW 1/4 SW 1/4 Section Number 23 Township Number 27 Range Number 1 EW
 County: Sedgwick

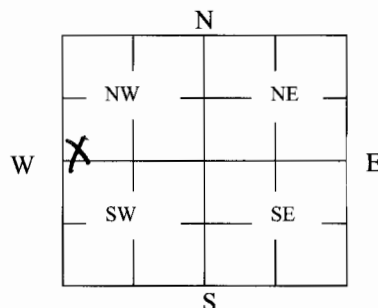
Distance and direction from nearest town or city street address of well if located within city?

140 N. Hillside Wichita, KS

2 WATER WELL OWNER: Town + Country Market Global Positioning Systems (decimal degrees, min. of 4 digits)

RR#, St. Address, Box #: P.O. Box 17087City, State ZIP Code: Wichita, KS 67217Latitude: 37°N, 41' 16.744"Longitude: 97°W, 17' 54.018"Elevation: 1320Datum: NAD 27Data Collection Method: USGS Topo Map

3 MARK WELL'S LOCATION WITH AN "X" IN SECTION BOX:

4 DEPTH OF WELL 44 ft.WELL'S STATIC WATER LEVEL 37 ft

WELL WAS USED AS:

1 Domestic

2 Irrigation

3 Feedlot

4 Industrial

5 Public Water Supply

6 Oil Field Water Supply

7 Domestic (Lawn & Garden)

8 Air Conditioning

9 Dewatering

☒ 10 Monitoring

11 Injection Well

12 Other

Was a chemical/bacteriological sample submitted to Department? Yes ☐ No ☒

5 TYPE OF BLANK CASING USED:

1 Steel

3 RMP (SR)

5 Wrought

7 Fiberglass

9 Other (Specify below)

☒ 2 PVC

4 ABS

6 Asbestos-Cement

8 Concrete Tile

Blank casing diameter 3 in. Was casing pulled? Yes ☒ No ☐ If yes, how much 3 feetCasing height above or below and surface 36 in.

6 GROUT PLUG MATERIAL: 1 Neat cement 2 Cement grout ☒ 3 Bentonite 4 Other

Grout Plug Intervals: From 44 ft. to 3 ft., From _____ ft. to _____ ft., From _____ to _____ ft.

What is the nearest source of possible contamination:

1 Septic tank

6 Seepage pit

☒ 7 Fuel Storage

16 Other (specify below)

2 Sewer lines

7 Pit privy

12 Fertilizer storage

3 Watertight sewer lines

8 Sewage lagoon

13 Insecticide storage

4 Lateral lines

9 Feedyard

14 Abandoned water well

Direction from well? North

5 Cess pool

10 Livestock pens

15 Oil well/Gas well

How many feet? 35

FROM	TO	PLUGGING MATERIALS	FROM	TO	PLUGGING MATERIALS
<u>44</u>	<u>3</u>	<u>bentonite grout</u>			
<u>3</u>	<u>0</u>	<u>native material</u>			

7 CONTRACTOR'S OR LANDOWNER'S CERTIFICATION: This water well was plugged under my jurisdiction and was completed on (mo/day/year) 11/2/07 and this record is true to the best of my knowledge and belief. Kansas Water Well Contractor's License No. 594. This Water Well Record was completed on (mo/day/year) 11/6/07 under the business name of Coranco Great Plains, Inc by (signature) Terry F. Mahalik

INSTRUCTIONS: Use typewriter or ballpoint pen. Please press firmly and print clearly. Please fill in blanks, underline or circle the correct answers. Send top three copies to Kansas Department of Health and Environment, Bureau of Water, Geology Section, 1000 SW Jackson St., Ste. 420, Topeka, Kansas 66612-1367. Telephone: 785/296-5522. Send one to Water Well Owner and retain one for your records. Visit us at <http://www.kdheks.gov/geo/waterwells>.