

## WATER WELL PLUGGING RECORD Form WWC-5P

KSA 82a-1212

ID NO.

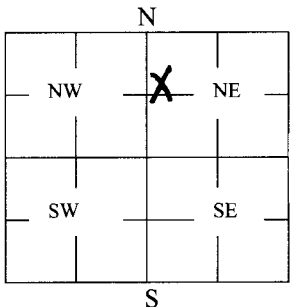
TFC MW4  
00164225

1 LOCATION OF WATER WELL: County: <u>Sedgwick</u>	Fraction <u>SW SW NW</u> <u>NW 1/4 NW 1/4 SW 1/4</u>	Section Number <u>23</u>	Township Number <u>27</u>	Range Number <u>1</u> <u>EDW</u>
--	---	-----------------------------	------------------------------	-------------------------------------

Distance and direction from nearest town or city street address of well if located within city?

140 N. Hillside Wichita, KS

2 WATER WELL OWNER: <u>Town + Country Market</u> RR#, St. Address, Box #: <u>P.O. Box 17087</u> City, State ZIP Code: <u>Wichita, KS 67217</u>	Global Positioning Systems (decimal degrees, min. of 4 digits) Latitude: <u>37°N, 41' 16.744"</u> Longitude: <u>97°W, 17' 54.018"</u> Elevation: <u>1320</u> Datum: <u>NAD 27</u> Data Collection Method: <u>USGS Topo Map</u>
--	---

3 MARK WELL'S LOCATION WITH AN "X" IN SECTION BOX: 	4 DEPTH OF WELL <u>42.5</u> ft. WELL'S STATIC WATER LEVEL <u>35</u> ft. WELL WAS USED AS: <table border="0"> <tr> <td>1 Domestic</td> <td>5 Public Water Supply</td> <td>9 Dewatering</td> </tr> <tr> <td>2 Irrigation</td> <td>6 Oil Field Water Supply</td> <td>10 <u>Monitoring</u></td> </tr> <tr> <td>3 Feedlot</td> <td>7 Domestic (Lawn &amp; Garden)</td> <td>11 Injection Well</td> </tr> <tr> <td>4 Industrial</td> <td>8 Air Conditioning</td> <td>12 Other</td> </tr> </table> Was a chemical/bacteriological sample submitted to Department? Yes <input type="checkbox"/> No <input checked="" type="checkbox"/>	1 Domestic	5 Public Water Supply	9 Dewatering	2 Irrigation	6 Oil Field Water Supply	10 <u>Monitoring</u>	3 Feedlot	7 Domestic (Lawn & Garden)	11 Injection Well	4 Industrial	8 Air Conditioning	12 Other
1 Domestic	5 Public Water Supply	9 Dewatering											
2 Irrigation	6 Oil Field Water Supply	10 <u>Monitoring</u>											
3 Feedlot	7 Domestic (Lawn & Garden)	11 Injection Well											
4 Industrial	8 Air Conditioning	12 Other											

5 TYPE OF BLANK CASING USED: 1 Steel <u>2 PVC</u> 3 RMP (SR) 4 ABS 5 Wrought 6 Asbestos-Cement 7 Fiberglass 8 Concrete Tile 9 Other (Specify below)	Blank casing diameter <u>3</u> in. Was casing pulled? Yes <input checked="" type="checkbox"/> No <input type="checkbox"/> Casing height above or below land surface <u>36</u> in. If yes, how much <u>3 feet</u>
--	---

6 GROUT PLUG MATERIAL: 1 Neat cement 2 Cement grout <u>3 Bentonite</u> 4 Other	Grout Plug Intervals: From <u>42.5</u> ft. to <u>3</u> ft., From _____ ft. to _____ ft., From _____ to _____ ft.
What is the nearest source of possible contamination: 1 Septic tank 2 Sewer lines 3 Watertight sewer lines 4 Lateral lines 5 Cess pool 6 Seepage pit 7 Pit privy 8 Sewage lagoon 9 Feedyard 10 Livestock pens 11 <u>Puel Storage</u> 12 Fertilizer storage 13 Insecticide storage 14 Abandoned water well 15 Oil well/Gas well 16 Other (specify below)	Direction from well? <u>North</u> How many feet? <u>120</u>

FROM	TO	PLUGGING MATERIALS	FROM	TO	PLUGGING MATERIALS
<u>42.5</u>	<u>3</u>	<u>bentonite grout</u>			
<u>3</u>	<u>0</u>	<u>native material</u>			

7 CONTRACTOR'S OR LANDOWNER'S CERTIFICATION: This water well was plugged under my jurisdiction and was completed on (mo/day/year) <u>1/2/07</u> and this record is true to the best of my knowledge and belief. Kansas Water Well Contractor's License No. <u>594</u> . This Water Well Record was completed on (mo/day/year) <u>1/16/07</u> under the business name of <u>Coranco Great Plains, Inc</u> by (signature) <u>Timothy A. Mark</u>
--

**INSTRUCTIONS:** Use typewriter or ballpoint pen. Please press firmly and print clearly. Please fill in blanks, underline or circle the correct answers. Send top three copies to Kansas Department of Health and Environment, Bureau of Water, Geology Section, 1000 SW Jackson St., Ste. 420, Topeka, Kansas 66612-1367. Telephone: 785/296-5522. Send one to Water Well Owner and retain one for your records. Visit us at <http://www.kdheks.gov/geo/waterwells>.